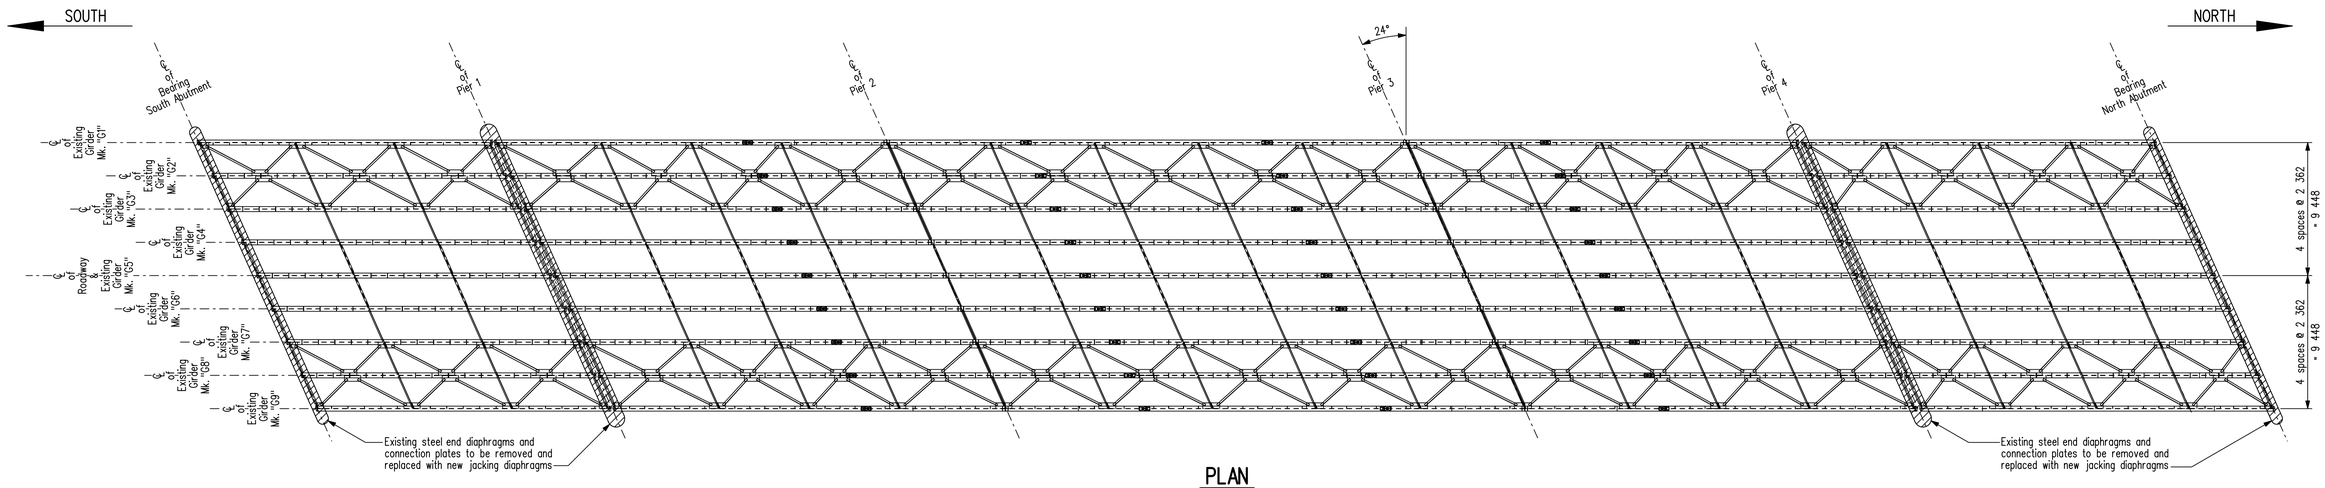

PLAN

Showing locations of end diaphragms to be removed and replaced.
Scale 1:200

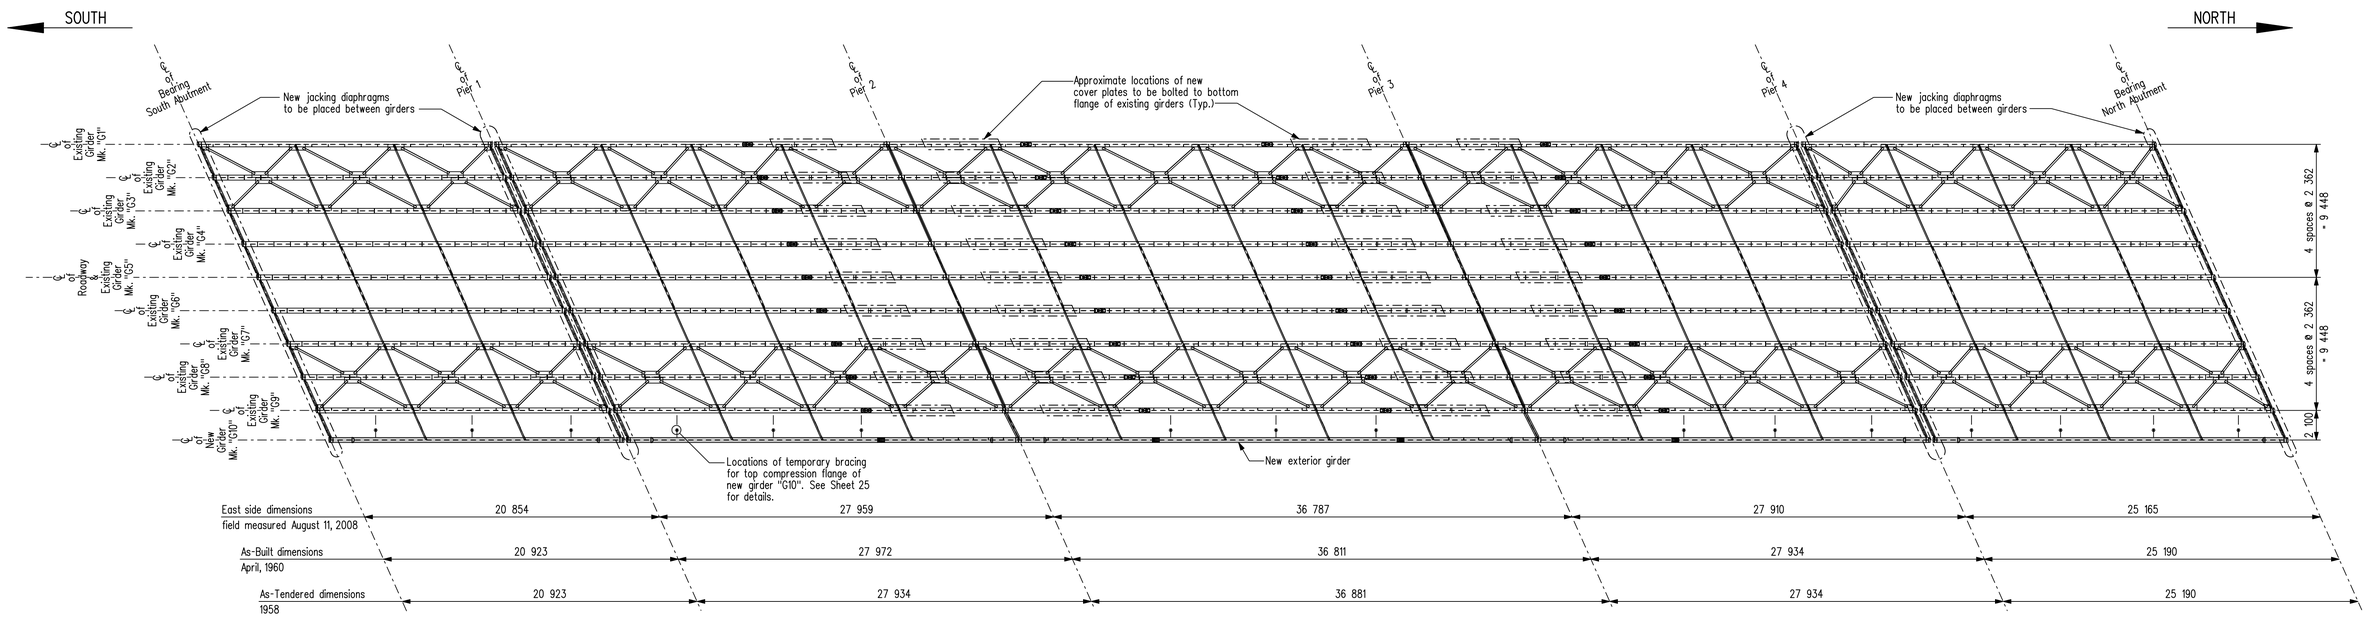

PLAN

Showing new girder and diaphragms and proposed modifications to existing girders.
Scale 1:200

NOTES:

1. For modifications to existing girders see Sheets No. 21-24.
2. For details of new girder Mk. "G10" see Sheets No. 13 & 15-20.
3. The Contractor shall confirm the actual span lengths and adjust the girder span length of the new girders as required.

REVISIONS		
10/03/04	J.J.	As built
DATE	BY	DESCRIPTION

PROVINCE OF MANITOBA
Original signed by
M. B. CHISLETT
09/04/20
REGISTERED PROFESSIONAL ENGINEER

PLANS OF GIRDERS

RECONSTRUCTION AND STRENGTHENING OF EXISTING BRIDGE
OVER ASSINIBOINE RIVER - CONTRACT ONE
ON P.T.H. No. 100 IN R.L.'S 72, 73 & 94
PARISH OF ST. CHARLES

CITY OF WINNIPEG

Manitoba
Infrastructure and Transportation
Water Control & Structures

RELEASED FOR CONSTRUCTION
BY: Original signed by Ruth J. Eden 09/05/01
DIRECTOR — DATE
STRUCTURES, DESIGN AND CONSTRUCTION BRANCH

DESIGN	BY: M.B.C.	
	CHECKED: M.W.H.	
DETAILS	BY: D.P.W.	
	CHECKED: M.B.C.	

SCALE: As Shown
SHEET No. 14
SITE No. 2924-00