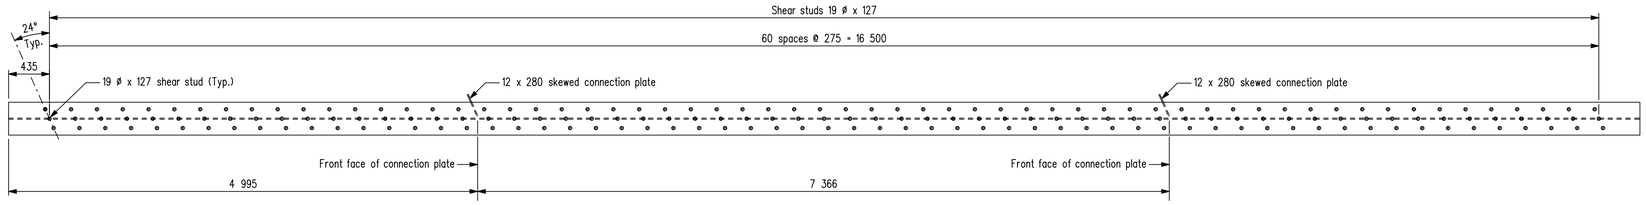

PLAN

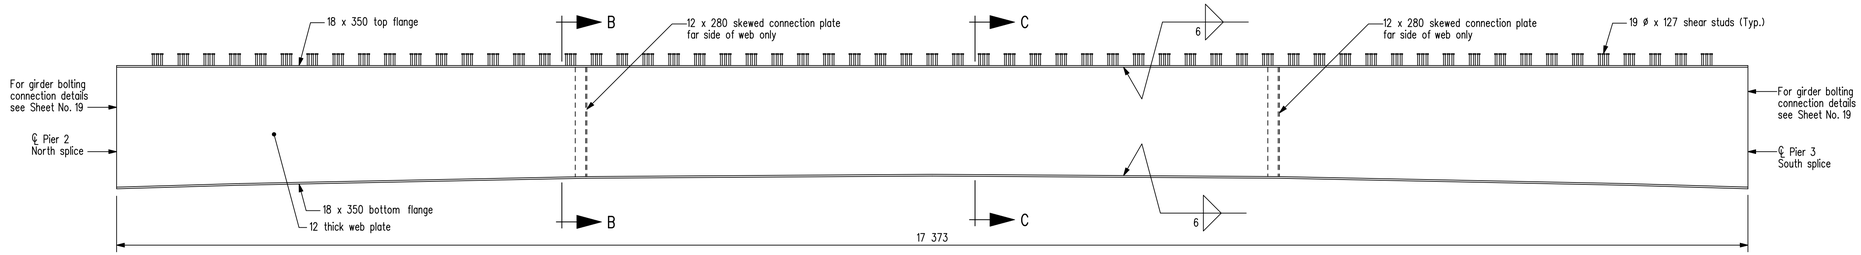

ELEVATION

PIER 2 NORTH SPLICE TO PIER 3 SOUTH SPLICE

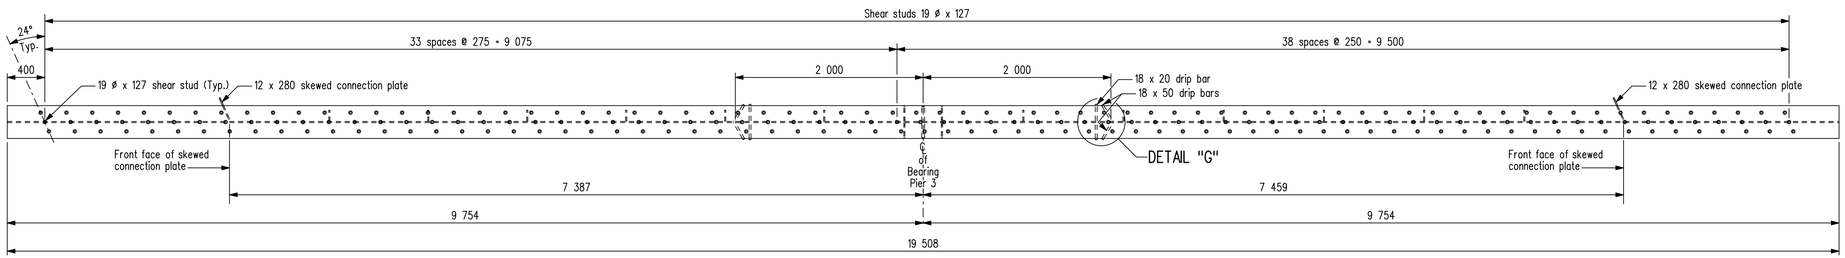

PLAN

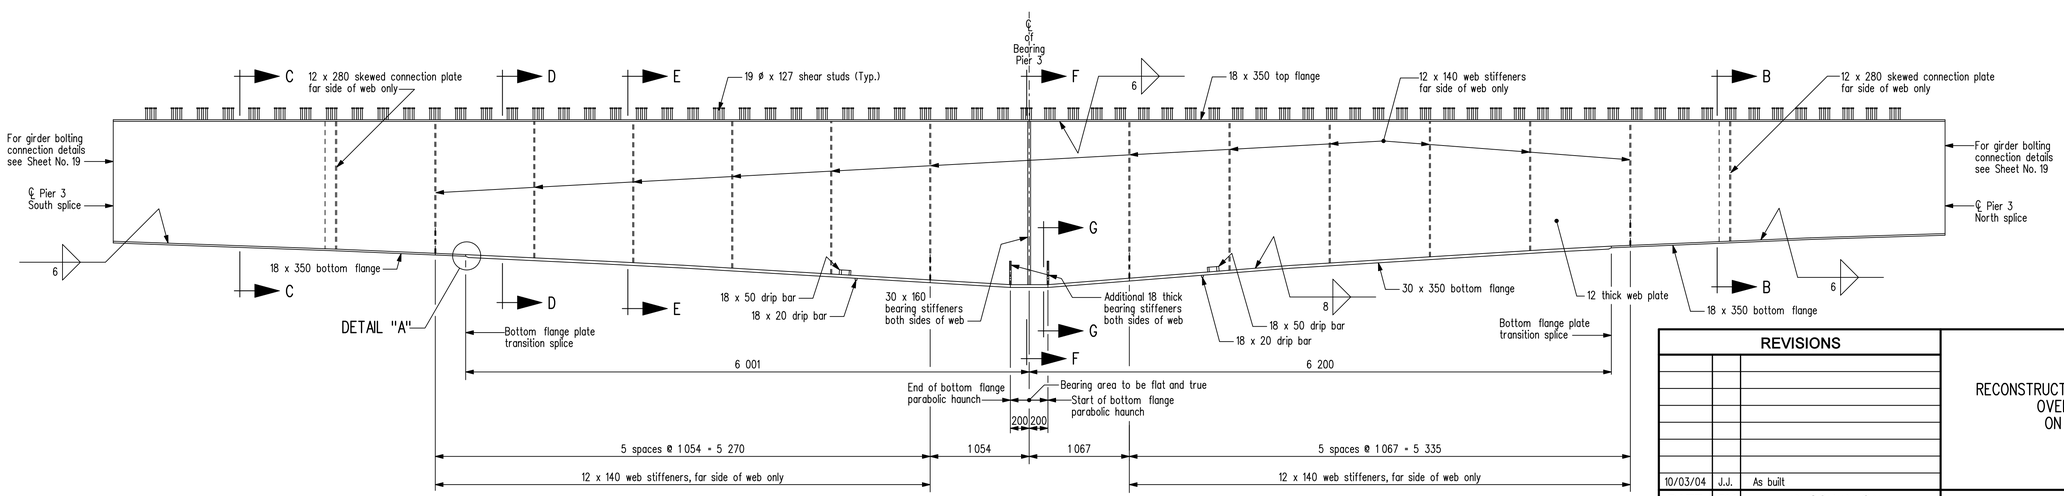

ELEVATION

PIER 3 SOUTH SPLICE TO PIER 3 NORTH SPLICE

NOTES:

1. For SECTIONS B-B & C-C see Sheet No. 15.
2. For SECTIONS D-D, E-E, F-F and G-G see Sheet No. 16.
3. For DETAIL "A" see Sheet No. 16.
4. For DETAIL "G" see Sheet No. 15.

REVISIONS

DATE	BY	DESCRIPTION
10/03/04	J.J.	As built

PROVINCE OF MANITOBA
Original signed by
M. B. CHISLETT
09/04/20
REGISTERED PROFESSIONAL ENGINEER

NEW GIRDER Mk. "G10"

RECONSTRUCTION AND STRENGTHENING OF EXISTING BRIDGE
OVER ASSINIBOINE RIVER - CONTRACT ONE
ON P.T.H. No. 100 IN R.L.'S 72, 73 & 94
PARISH OF ST. CHARLES

CITY OF WINNIPEG

Manitoba
Infrastructure and Transportation
Water Control & Structures

RELEASED FOR CONSTRUCTION BY:
Original signed by
Ruth J. Eden
09/05/01
DIRECTOR — DATE
STRUCTURES, DESIGN AND CONSTRUCTION BRANCH

DESIGN	BY: M.B.C.	SCALE: 1:30
	CHECKED: M.W.H.	SHEET No. 17
DETAILS	BY: D.P.W.	
	CHECKED: M.B.C.	SITE No. 2924-00