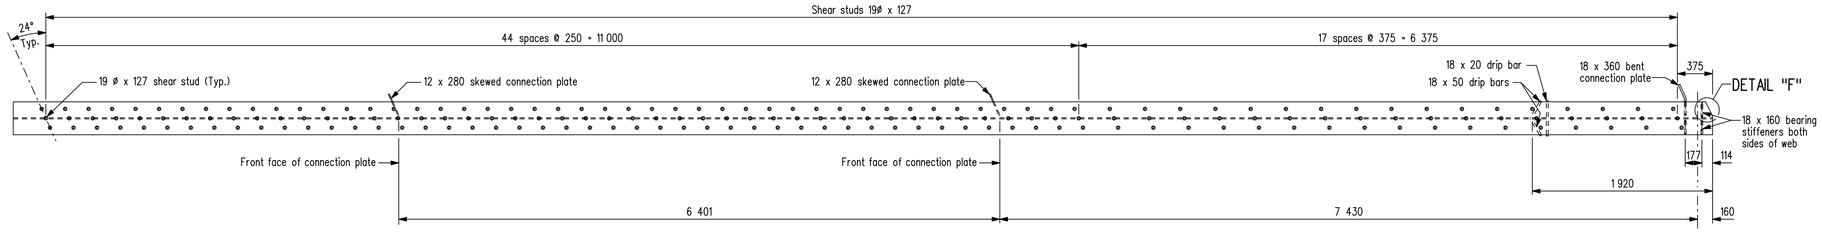

PLAN

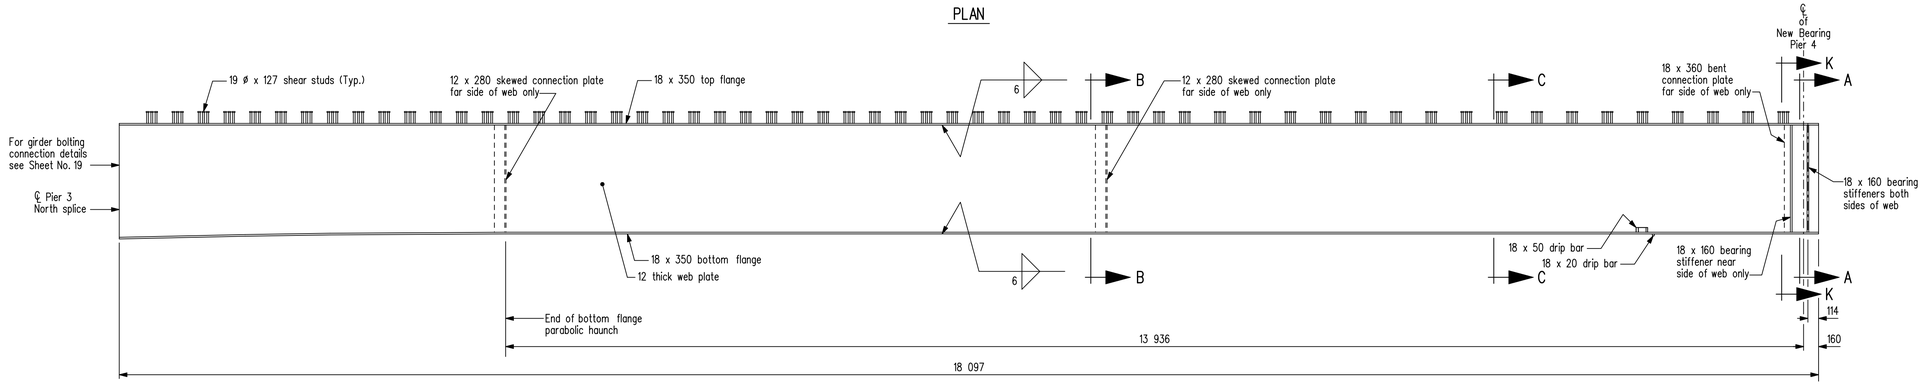

ELEVATION

PIER 3 NORTH SPLICE TO PIER 4

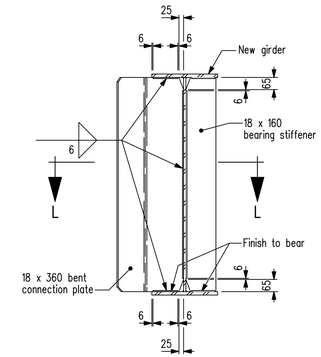

SECTION K-K

Showing bearing stiffener and bent connection plate for jacking diaphragm. Shear studs not shown. Scale 1 : 15

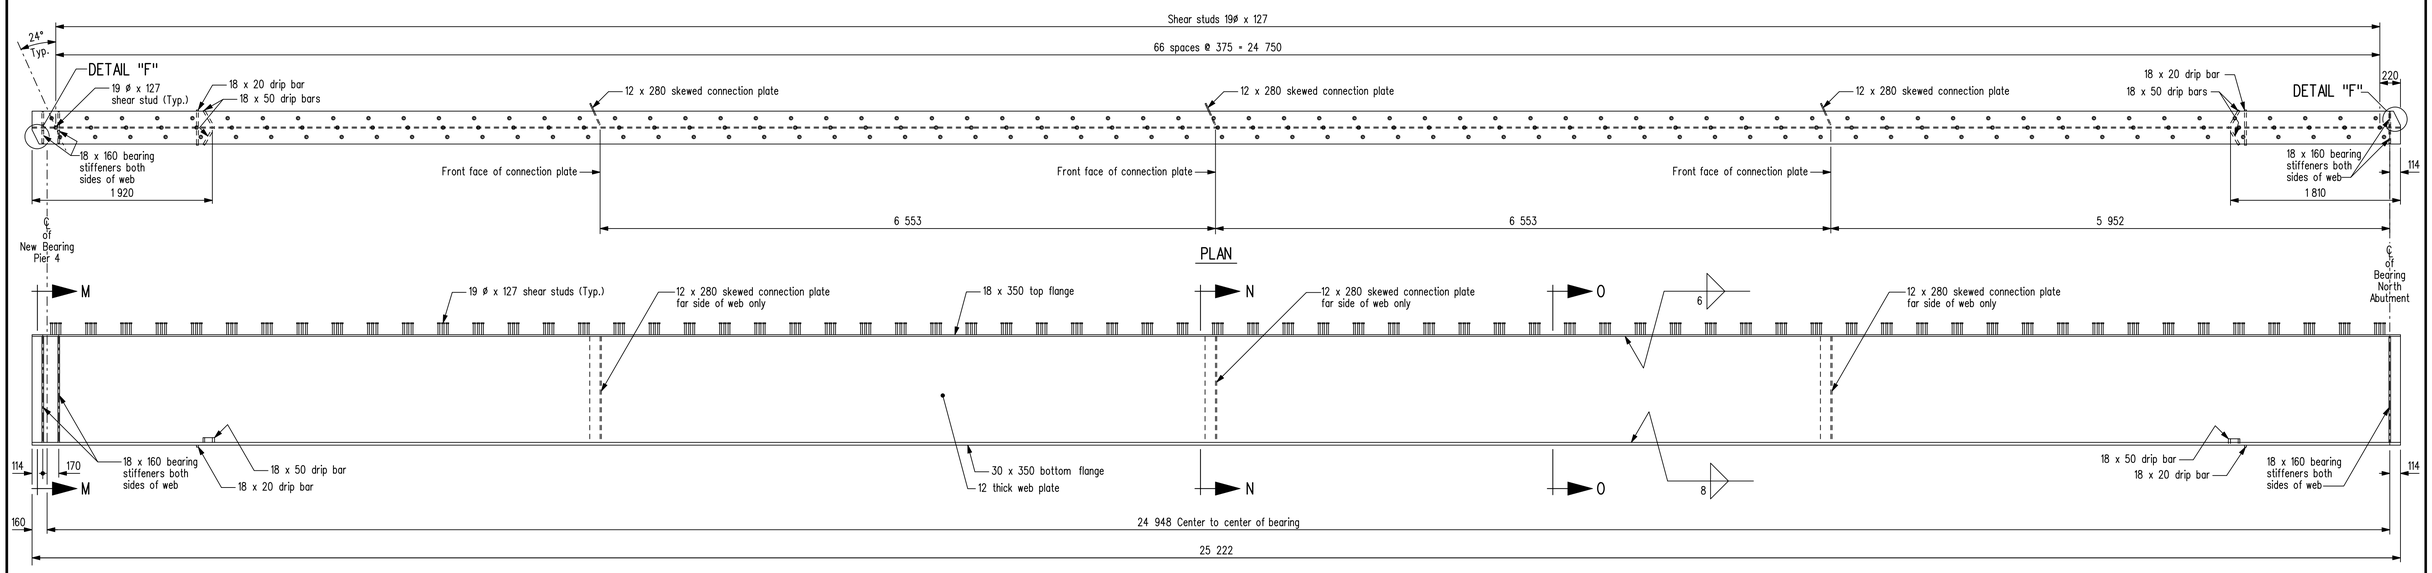

ELEVATION

PIER 4 TO NORTH ABUTMENT

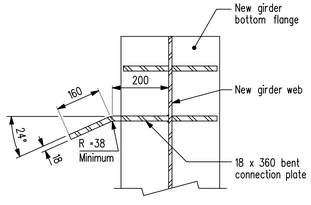

SECTION L-L

Showing bent connection plate for jacking diaphragm. Scale 1 : 10

NOTE:

1. For SECTIONS A-A, B-B & C-C see Sheet No. 15.
2. For SECTIONS M-M, N-N & O-O see Sheet No. 19.
3. For DETAIL "F" see Sheet No. 15.

REVISIONS		
10/03/04	J.J.	As built
DATE	BY	DESCRIPTION

PROVINCE OF MANITOBA
Original signed by
M. B. CHISLETT
09/04/20
REGISTERED PROFESSIONAL ENGINEER

NEW GIRDER Mk. "G10"

RECONSTRUCTION AND STRENGTHENING OF EXISTING BRIDGE
OVER ASSINIBOINE RIVER - CONTRACT ONE
ON P.T.H. No. 100 IN R.L.'S 72, 73 & 94
PARISH OF ST. CHARLES

CITY OF WINNIPEG

Manitoba
Infrastructure and Transportation
Water Control & Structures

RELEASED FOR CONSTRUCTION BY:
Original signed by
Ruth J. Eden
09/05/01

DIRECTOR — DATE
STRUCTURES, DESIGN AND CONSTRUCTION BRANCH

DESIGN	BY: M.B.C.	SCALE: 1 : 30 or
	CHECKED: M.W.H.	SHEET No. 18
DETAILS	BY: D.P.W.	As Shown
	CHECKED: M.B.C.	SITE No. 2924-00

...\Contract_1\292400rehab.dgn 2010-03-04 3:26:28 PM