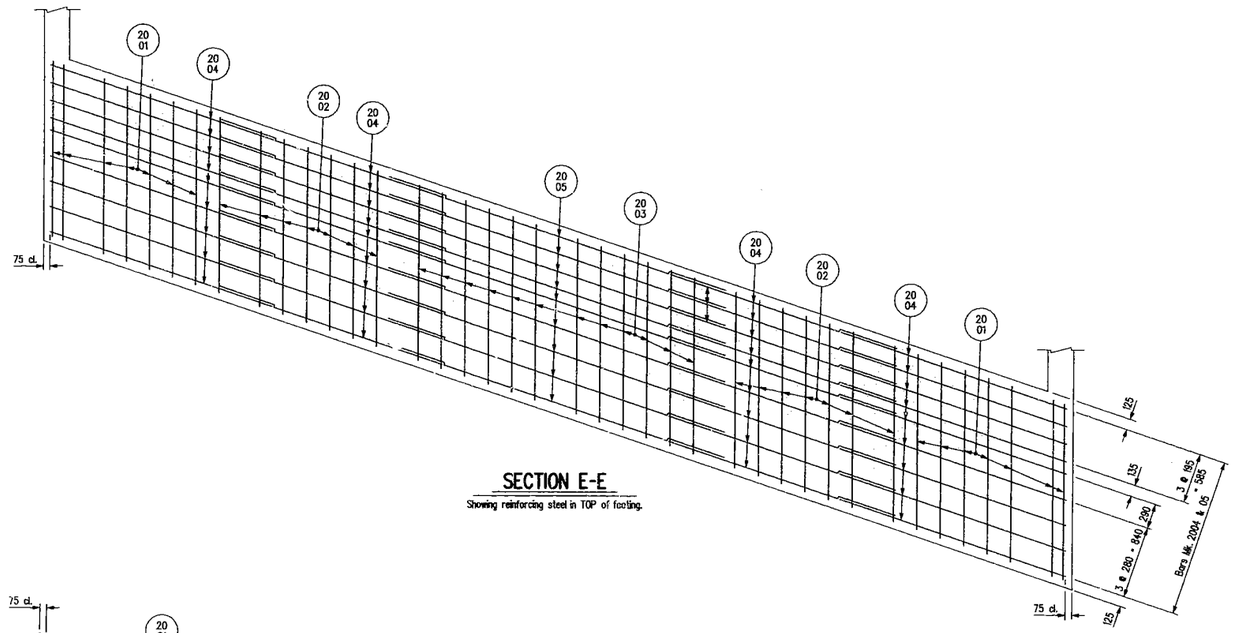

SECTION E-E

Showing reinforcing steel in TOP of footing.

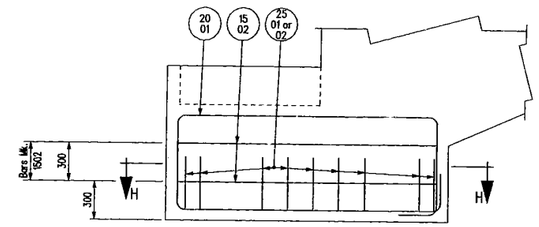

SECTION G-G

Showing reinforcing steel in END of footing.
Wingwall reinforcing not shown.
Scale 1:20

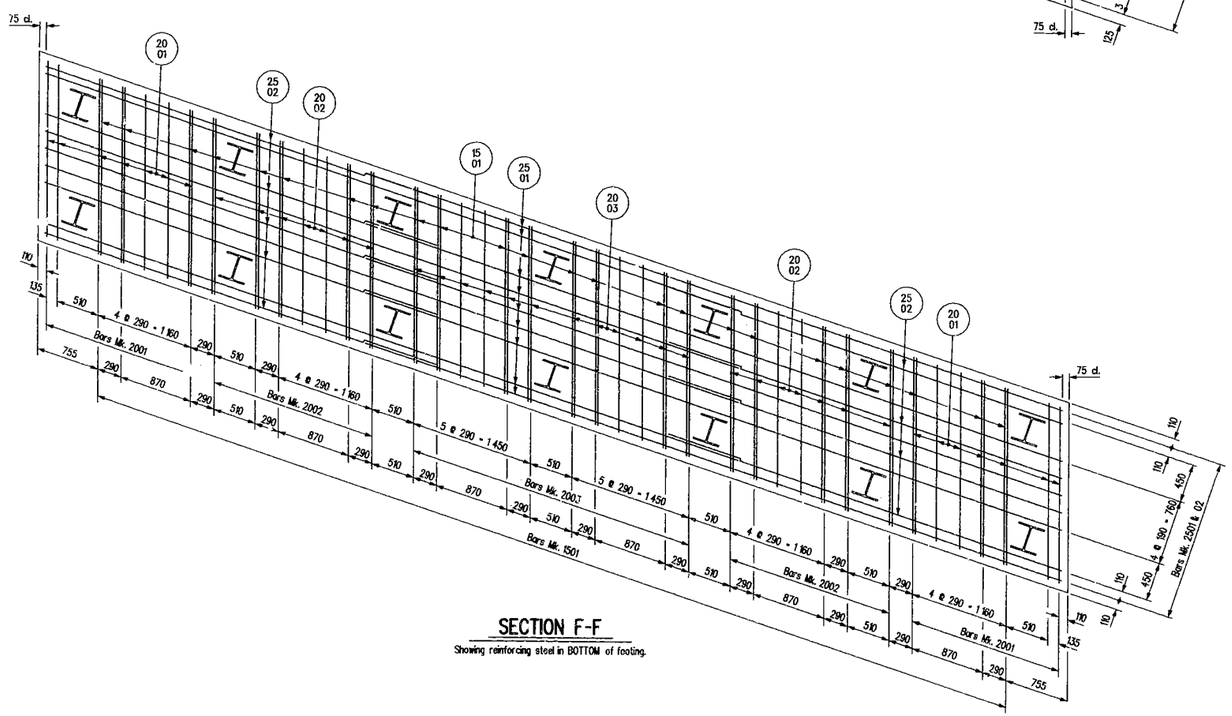

SECTION F-F

Showing reinforcing steel in BOTTOM of footing.

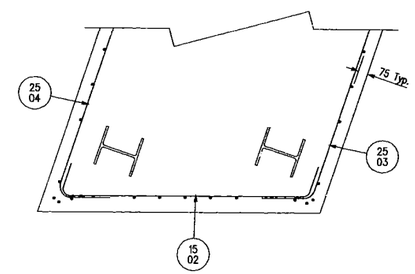

SECTION H-H

Scale 1:20

NOTE:

For locations of SECTIONS E-E, F-F & G-G see Sheets No. 12 & 14.

REVISIONS		
OCT 31/07	R.A	AS BUILT
DATE	BY	DESCRIPTION

PROVINCE OF MANITOBA
A.H. PANKRATZ
Oct 12, 2005
REGISTERED PROFESSIONAL ENGINEER

ABUTMENT REINFORCING DETAILS FOR SU.1 & SU.4

FOR PROPOSED 69 714 LONG R.C. BRIDGE
OVER SEINE RIVER DIVERSION
ON P.T.H. No. 59 SOUTH BOUND LANES, 10 900 ROADWAY
IN SEC. 28-8-4E

R.M. OF RITCHOT

Manitoba Transportation and Government Services
Bridges and Structures Branch

RELEASED FOR CONSTRUCTION BY:

Oct. 12/05
DIRECTOR OF BRIDGES AND STRUCTURES — DATE

DESIGN	BY: AHP	SCALE: 1:30 or As Shown	SHEET No. 16
	CHECKED: JBJ		
DETAILS	BY: D.P.W.		SITE No. 693-02
	CHECKED: AHP		

0693D2V06\02abutment.dgn 10/11/2005 9:02:57 AM