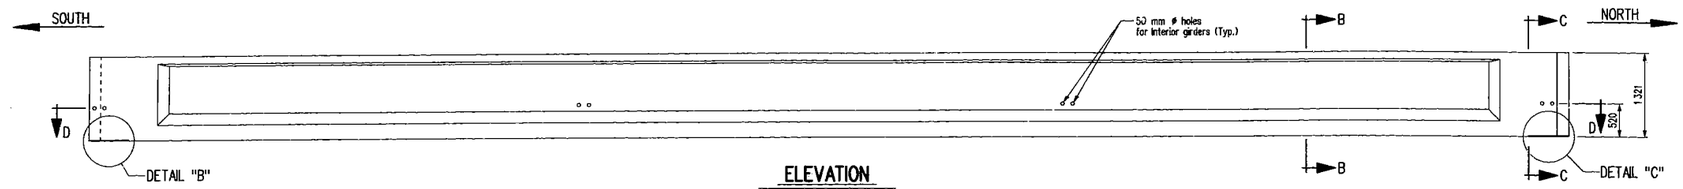

ELEVATION

Typical for Girders Mk. "G3" & "G9"

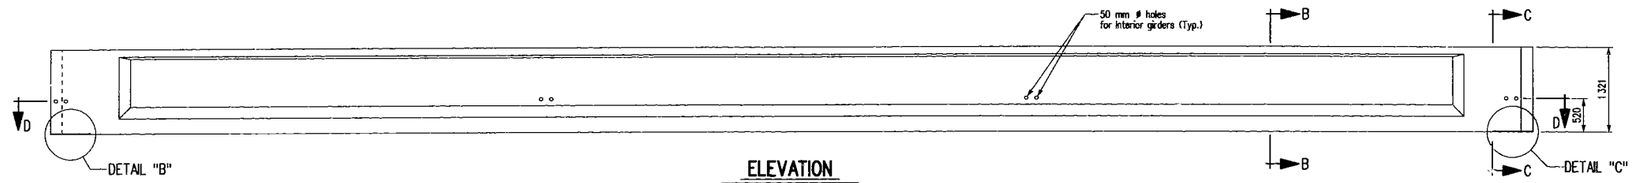

ELEVATION

Typical for Girders Mk. "G6"

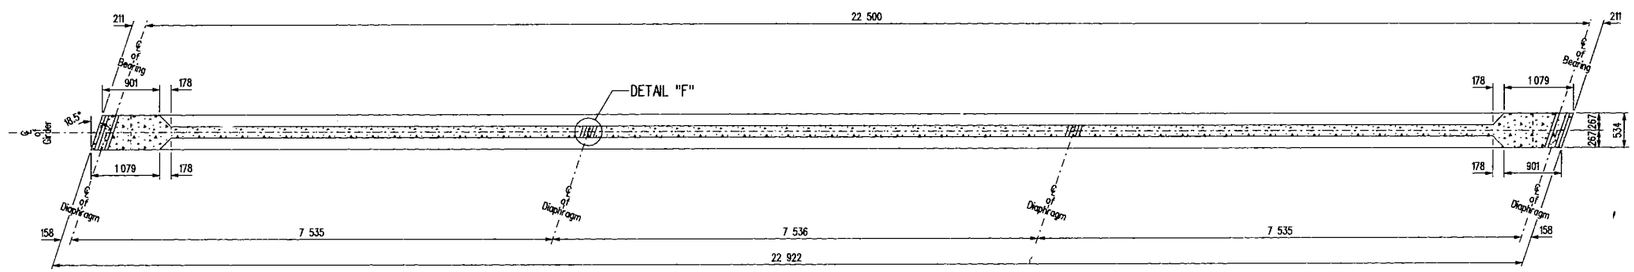

SECTION D-D

Typical for all INTERIOR Girders

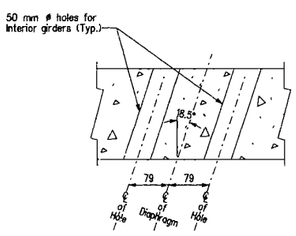

DETAIL "F"

Typical at all diaphragm hole locations.
Scale 1:5

NOTES:

1. For SECTIONS B-B & C-C see Sheet No. 25.
2. For DETAIL "B", DETAIL "C" and DETAIL "E" see Sheet No. 25.

REVISIONS		
OCT 31/07	R.A	AS BUILT
DATE	BY	DESCRIPTION

PROVINCE OF MANITOBA
A. H. PANKRATZ
Jan 11, 2005
REGISTERED PROFESSIONAL ENGINEER

GIRDER CONCRETE DETAILS

FOR PROPOSED 69 714 LONG R.C. BRIDGE
OVER SEINE RIVER DIVERSION
ON P.T.H. No. 59 SOUTH BOUND LANES, 10 900 ROADWAY
IN SEC. 28-8-4E

R.M. OF RITCHOT

Manitoba Transportation and Government Services
Bridges and Structures Branch

RELEASED FOR CONSTRUCTION
BY:
DIRECTOR OF BRIDGES AND STRUCTURES — DATE: Jan 12/05

DESIGN	BY: A.H.P.	SCALE: 1:40 or As Shown
	CHECKED: J.B.I.	SHEET No. 26
DETAILS	BY: D.P.W.	SITE No. 693-02
	CHECKED: A.H.P.	