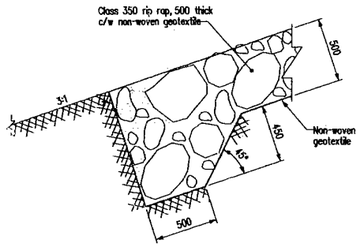

EDGE TREATMENT

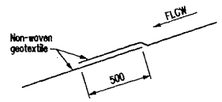

OVERLAPPING DETAILS

RIP RAP DETAILS

Not to Scale

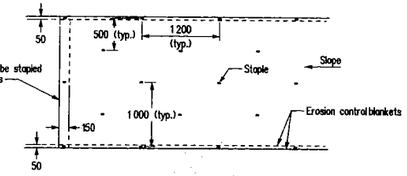

STAPLING DETAIL

Scale 1:40

NOTES:

1. Slope surface shall be free of rocks, clods, sticks and grass. Blankets shall have good soil contact.
2. Lay blankets loosely and stake or staple to maintain direct contact with the soil. DO NOT STRETCH.
3. Seed shall be placed prior to placing blanket.

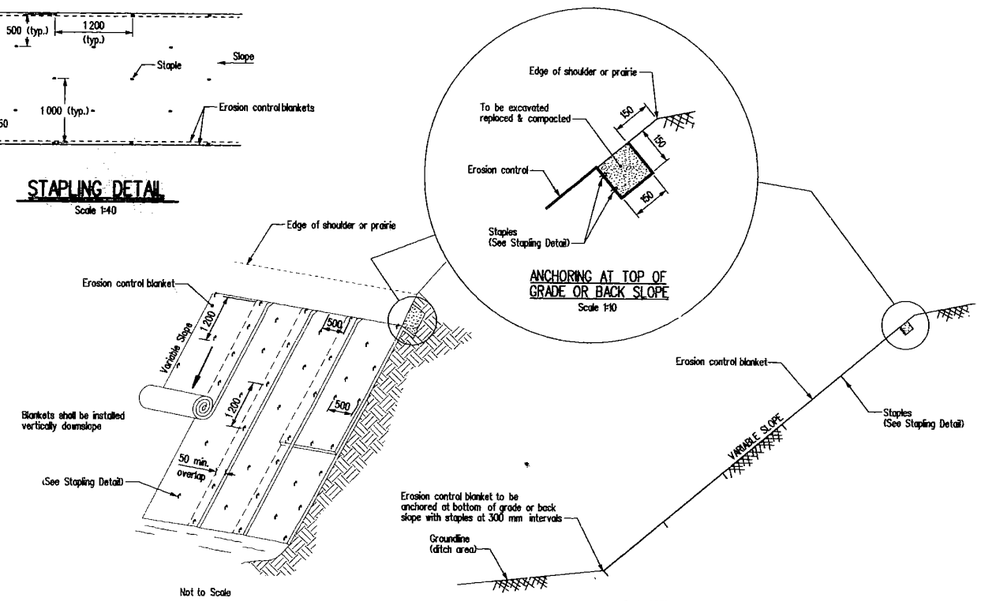

EROSION CONTROL BLANKET DETAILS

Erosion control blanket on grade and back slope
Scale As Shown

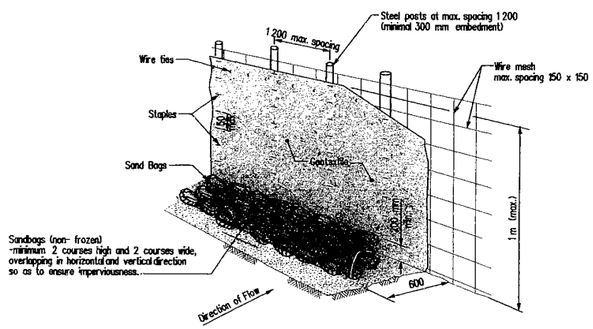

ISOMETRIC VIEW

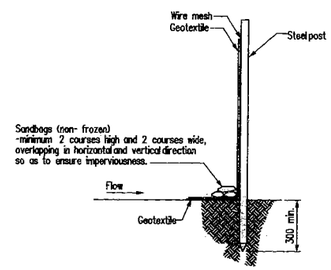

SECTION

REINFORCED SILT BARRIER DETAIL (FROZEN GROUND CONDITIONS)

Not to Scale

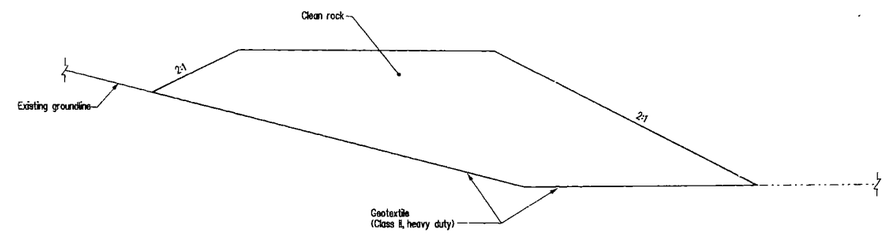

TEMPORARY ACCESS ROAD DETAILS

Showing Temporary Access Road Cross-Section
Not to Scale

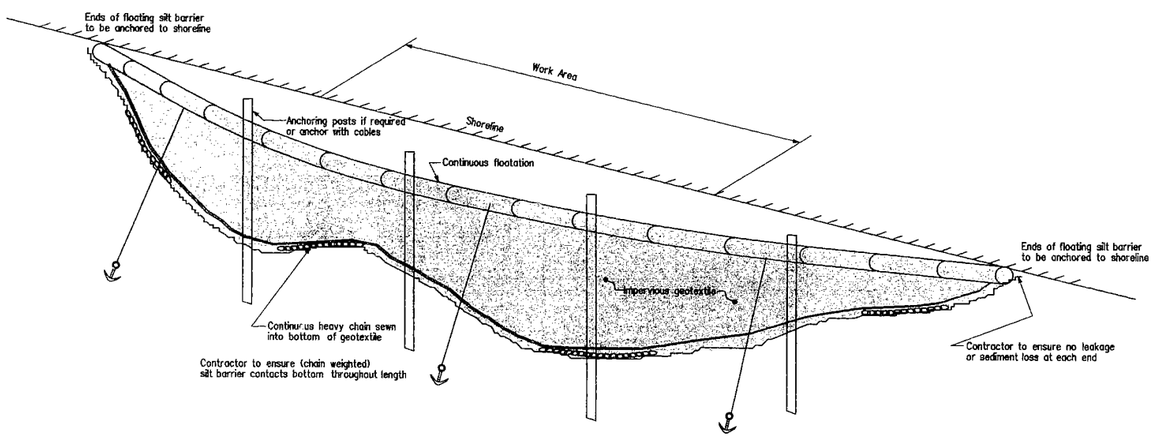

FLOATING SILT BARRIER

Shall be pre-manufactured to suit site conditions
Not to Scale

REVISIONS		
OCT 31/07	R.A	AS BUILT
DATE	BY	DESCRIPTION

PROVINCE OF MANITOBA
R.D. ANDRUSHUK
Member
22608
REGISTERED PROFESSIONAL ENGINEER

SITE AND EROSION CONTROL DETAILS

FOR PROPOSED 69 714 LONG R.C. BRIDGE
OVER SEINE RIVER DIVERSION
ON P.T.H. No. 59 SOUTH BOUND LANES, 10 900 ROADWAY
IN SEC. 28-8-4E

R.M. OF RITCHOT

Manitoba Transportation and Government Services
Bridges and Structures Branch

RELEASED FOR CONSTRUCTION
BY:
Oct. 13/05
DIRECTOR OF BRIDGES AND STRUCTURES — DATE

DESIGN	BY: R.A.	SCALE: As shown	SHEET No. 5
	CHECKED:		
DETAILS	BY: K.P.		SITE No. 693-02
	CHECKED:		

V:\59\3020\69302\general.dgn 10/12/2005 1:30:42 PM