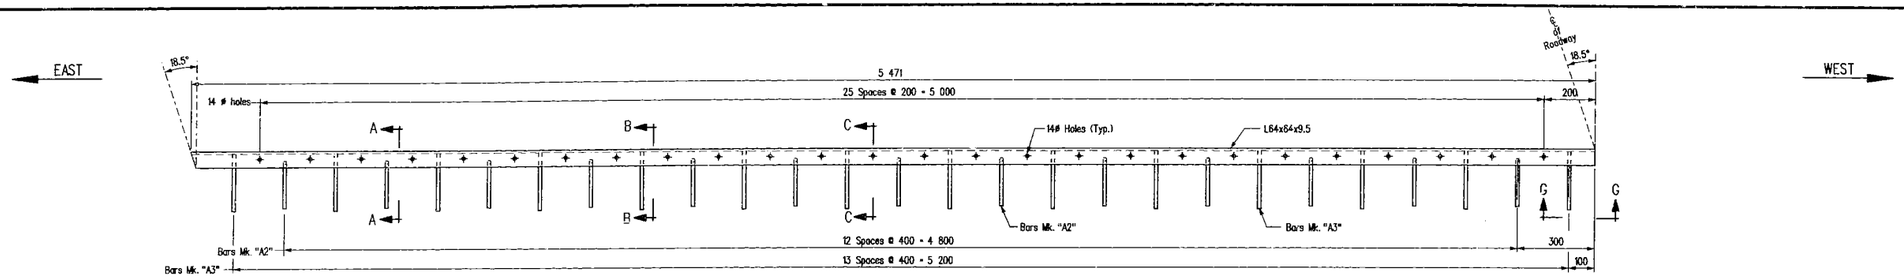

EDGE ANGLE Mk. "E1"

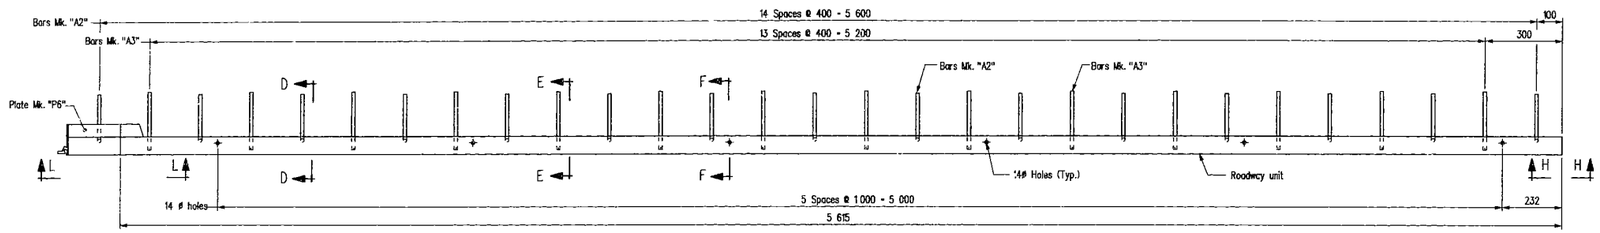

EXPANSION UNIT Mk. "E2"

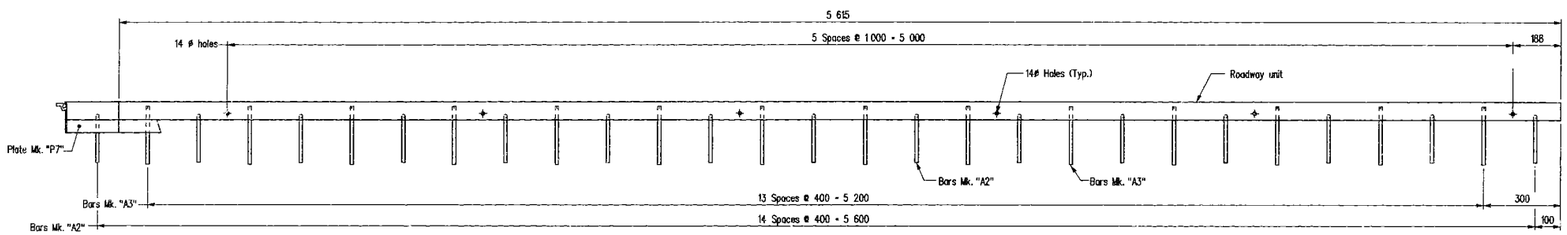

EXPANSION UNIT Mk. "E3"

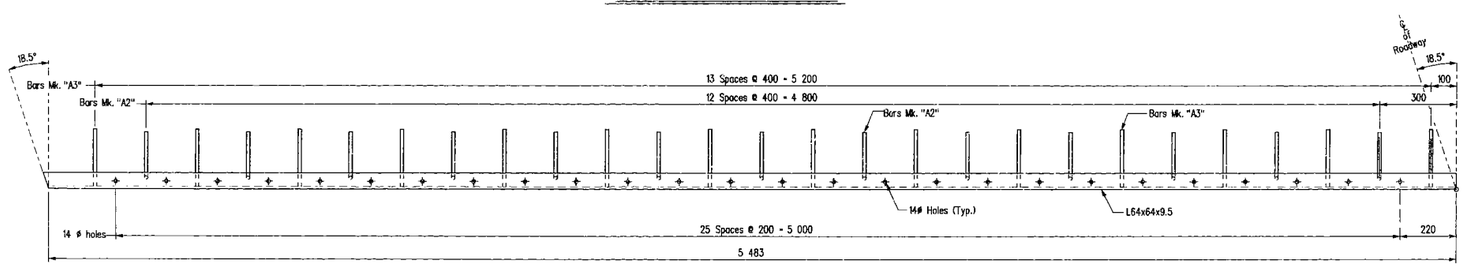

EDGE ANGLE Mk. "E4"

NOTE :

For Sections see sheet No. 45.

REVISIONS		
OCT 31/07	R.A.	AS BUILT
DATE	BY	DESCRIPTION

PROVINCE OF MANITOBA
A.H. PANKRATZ
OCT 12, 2005
REGISTERED PROFESSIONAL ENGINEER

EXPANSION JOINT DETAILS

FOR PROPOSED 69 714 LONG R.C. BRIDGE
OVER SEINE RIVER DIVERSION
ON P.T.H. No. 59 SOUTH BOUND LANES, 10 900 ROADWAY
IN SEC. 28-8-4E

R.M. OF RITCHOT

Manitoba
Transportation and
Government Services

Bridges and Structures Branch

RELEASED FOR CONSTRUCTION
BY:

Oct. 13/05
DIRECTOR OF BRIDGES AND STRUCTURES — DATE

DESIGN	BY: A.H.P.	SCALE: 1:10	SHEET No. 42
	CHECKED: J.B.L.		
DETAILS	BY: G.S.		
	CHECKED: A.H.P.		SITE No. 693-02