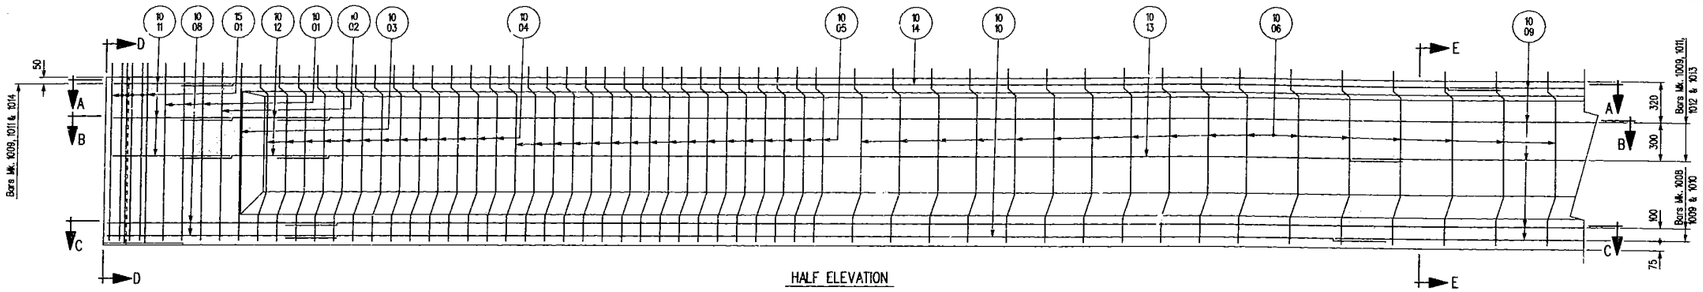

HALF ELEVATION

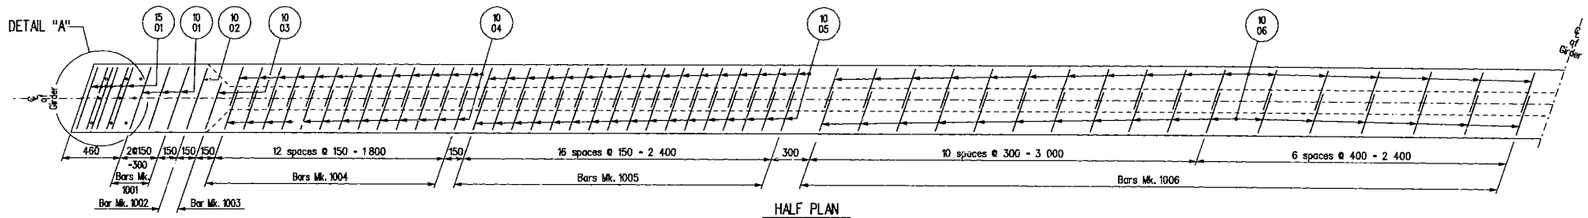

HALF PLAN

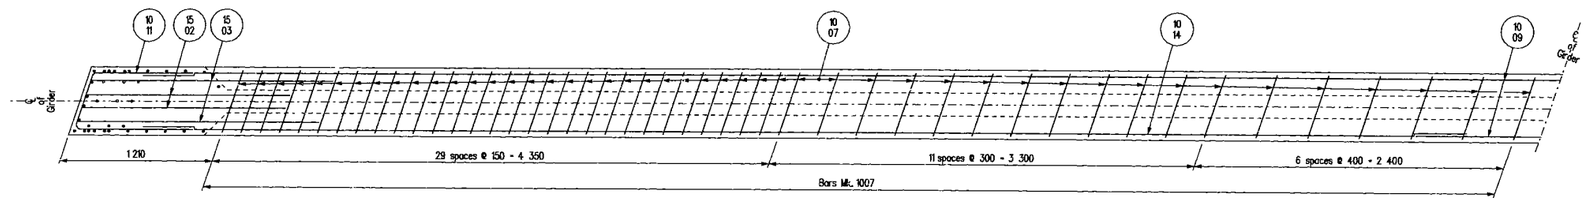

SECTION A-A

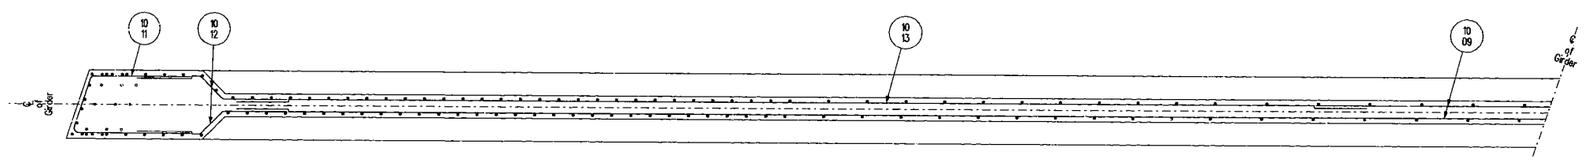

SECTION B-B

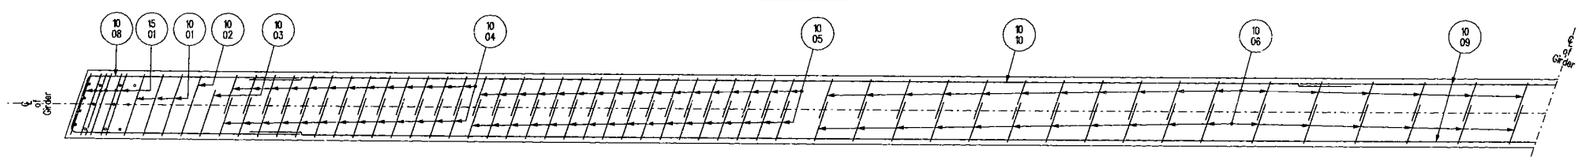

SECTION C-C

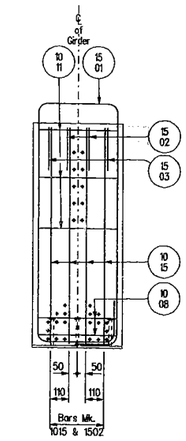

SECTION D-D
Scale 1:15

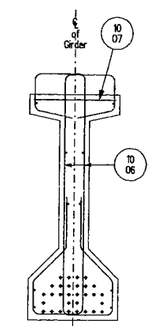

SECTION E-E
Scale 1:15

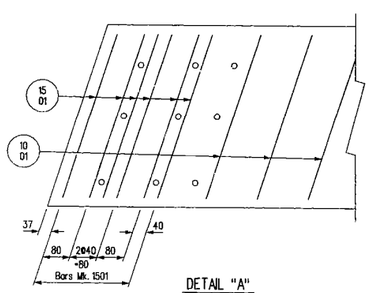

DETAIL "A"
Showing locations of bars Mk. 1501 at ends of girders.
Scale 1:7.5

GIRDER REINFORCING DETAILS

Typical for all girders.

NOTES:

1. Extend bottom 6-13 mm strands at piers, see Sheet No. 27.
2. For Bill of Reinforcing Steel see Sheet No. 29.
3. For Bill of Miscellaneous Metal see Sheet No. 29.

REVISIONS		
OCT 31/07	R.A	AS BUILT
DATE	BY	DESCRIPTION

PROVINCE OF MANITOBA — A. H. PANKRATZ — REGISTERED PROFESSIONAL ENGINEER

GIRDER REINFORCING DETAILS

FOR PROPOSED 69 714 LONG R.C. BRIDGE
OVER SEINE RIVER DIVERSION
ON P.T.H. No. 59 SOUTH BOUND LANES, 10 900 ROADWAY
IN SEC. 28-8-4E

R.M. OF RITCHOT

Manitoba Transportation and Government Services
Bridges and Structures Branch

RELEASED FOR CONSTRUCTION BY:
DIRECTOR OF BRIDGES AND STRUCTURES — DATE

DESIGN	BY: A.H.P.	SCALE: 1:20 or As Shown
	CHECKED: J.B.L.	SHEET No. 28
DETAILS	BY: D.P.W.	SITE No. 693-02
	CHECKED: A.H.P.	