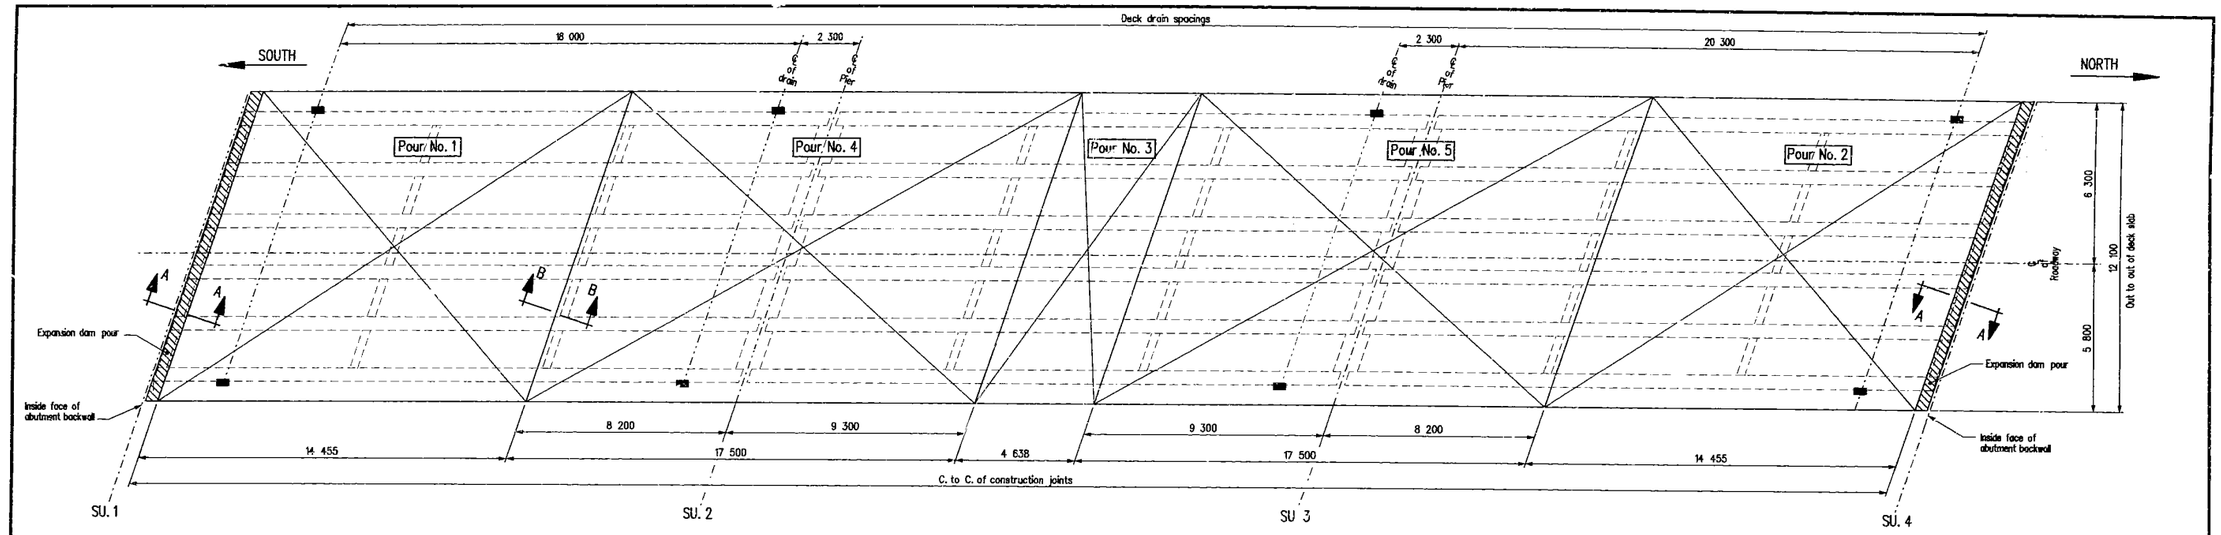

PLAN OF 3-SPAN CONTINUOUS DECK SLAB

(DECK SLAB CONCRETE POURING SEQUENCE)

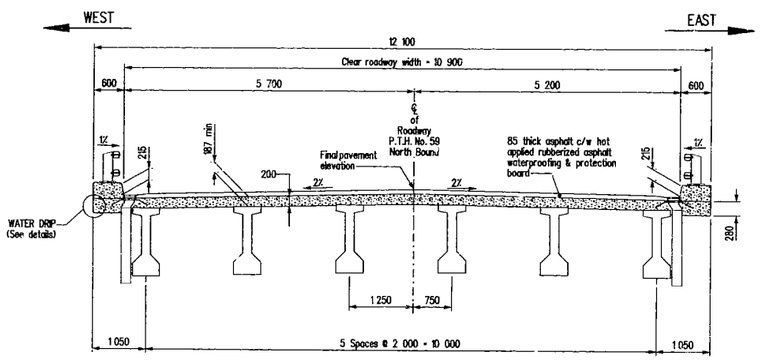

TYPICAL CROSS SECTION

Normal to ℄ of Roadway
Scale 1:50

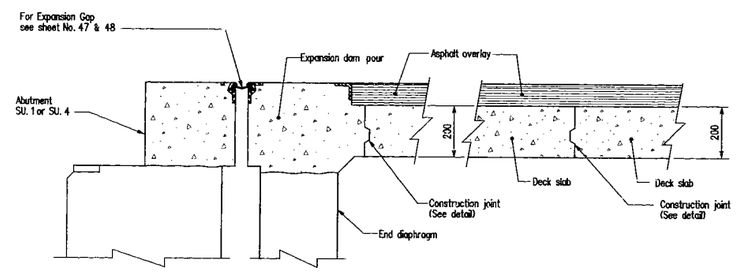

SECTION A-A

Scale 1:10

SECTION B-B

Scale 1:10

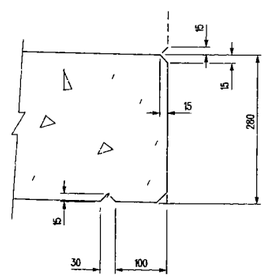

WATER DRIP DETAILS

Scale : 1:5

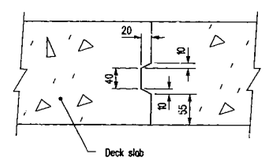

CONSTRUCTION JOINT DETAILS

Scale : 1:5

REVISIONS		
OCT31/07	R.A	AS BUILT
DATE	BY	DESCRIPTION

PROVINCE OF MANITOBA — A. H. PANKRATZ — Oct 17, 2005 — REGISTERED PROFESSIONAL ENGINEER

DECK SLAB CONCRETE DETAILS

FOR PROPOSED 69 714 LONG R.C. BRIDGE
OVER SEINE RIVER DIVERSION
ON P.T.H. No. 59 SOUTH BOUND LANES, 10 900 ROADWAY
IN SEC. 28-8-4E

R.M. OF RITCHOT

Manitoba Transportation and Government Services
Bridges and Structures Branch

RELEASED FOR CONSTRUCTION BY:
Oct 13/05
DIRECTOR OF BRIDGES AND STRUCTURES — DATE

DESIGN	BY: A.H.P.	
	CHECKED: J.B.L.	
DETAILS	BY: G.S.	
	CHECKED: A.H.P.	

SCALE: 1:100 or as shown
SHEET No. 33
SITE No. 693-02

ra_sem 090502 090202deck.dgn 10/11/2005 9:03:15 AM