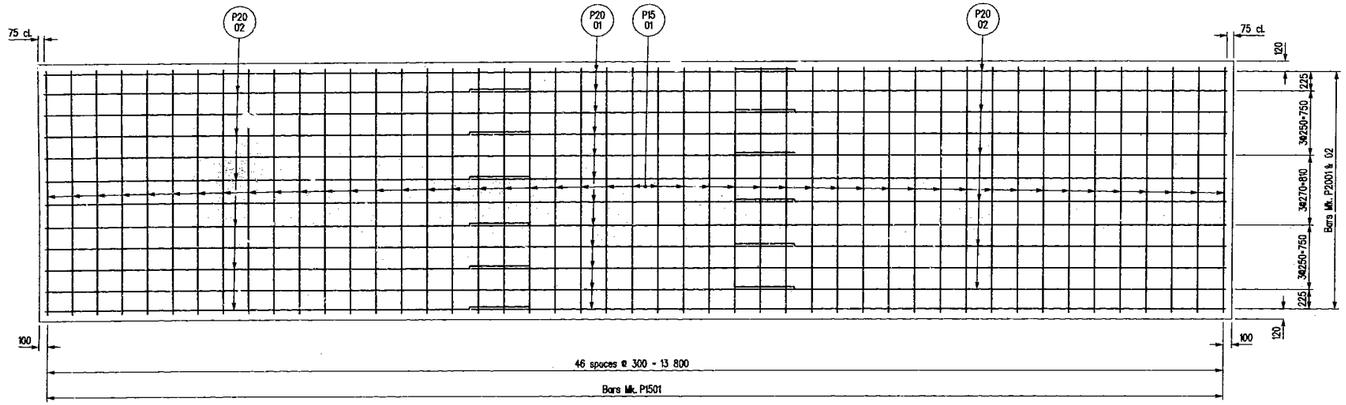

SECTION C-C

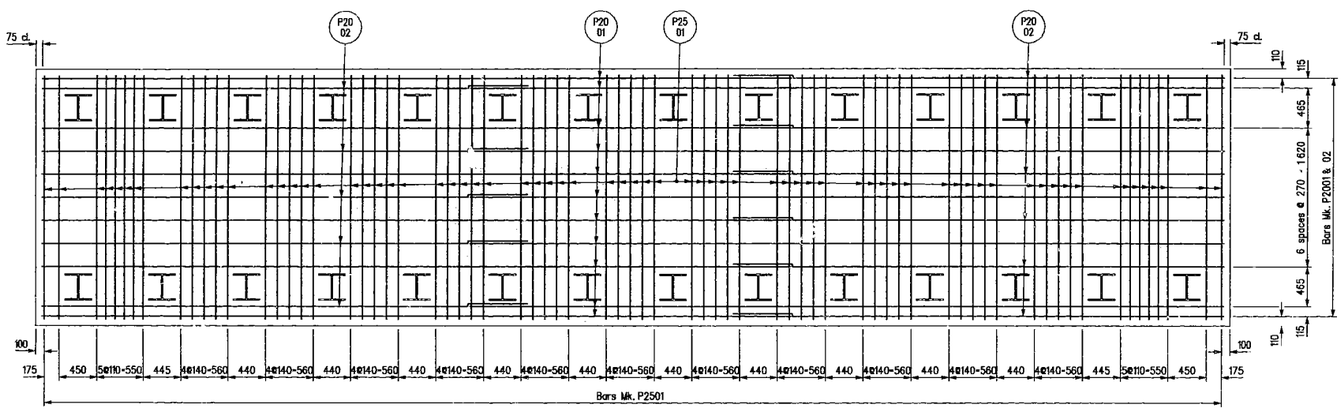

SECTION D-D

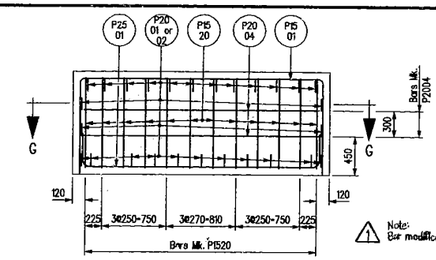

END VIEW F-F

Note:
Bar modification applies to SU3 only.

SECTION AB-1

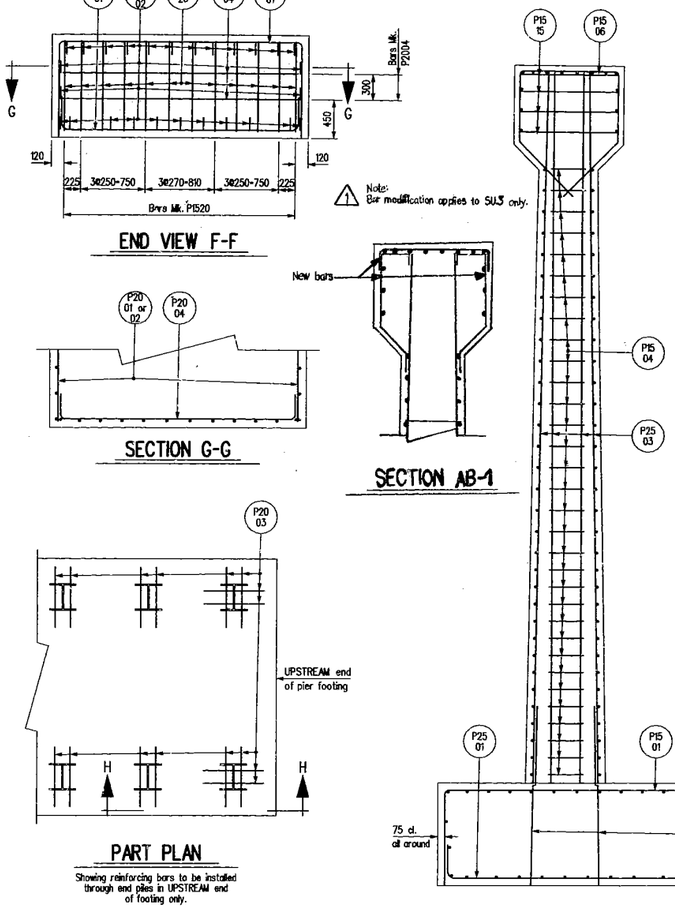

SECTION E-E

PART PLAN

Showing reinforcing bars to be installed through end piles in UPSTREAM end of footing only.

SECTION G-G

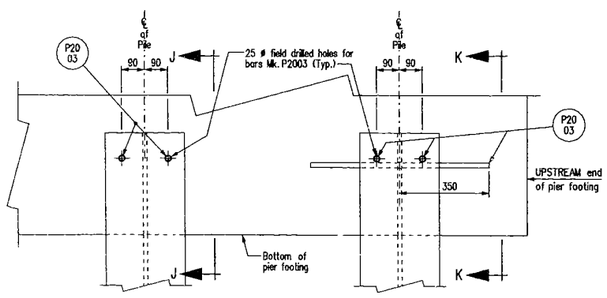

SECTION H-H

Scale 1 : 10

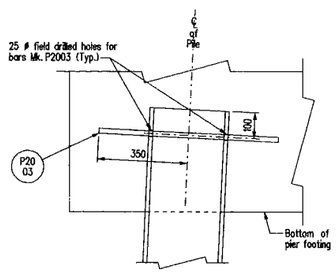

SECTION J-J

Scale 1 : 10

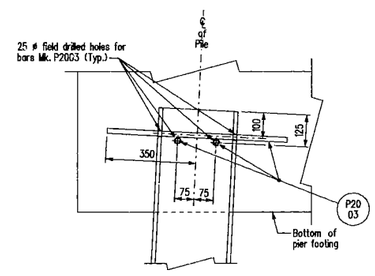

SECTION K-K

Scale 1 : 10

NOTES:

1. Concrete cover shall be 60 mm unless noted otherwise.
2. For locations of SECTIONS C-C, D-D, E-E and END VIEW F-F see Sheet No. 21.

REVISIONS		
OCT 31/07	R.A	AS BUILT
DATE	BY	DESCRIPTION

PIER REINFORCING DETAILS

FOR PROPOSED 69 714 LONG R.C. BRIDGE
OVER SEINE RIVER DIVERSION
ON P.T.H. No. 59 SOUTH BOUND LANES, 10 900 ROADWAY
IN SEC. 28-8-4E

R.M. OF RITCHOT

Manitoba Transportation and Government Services
Bridges and Structures Branch

PROVINCE OF MANITOBA
S. L. DONACHUK
Oct 11/05
REGISTERED ENGINEER

RELEASED FOR CONSTRUCTION
BY:
Oct. 31/05
DIRECTOR OF BRIDGES AND STRUCTURES — DATE

DESIGN	BY: S.L.D.	SCALE: 1:30 or As Shown	SHEET No. 22
	CHECKED: A.H.P.		
DETAILS	BY: O.P.W.		SITE No. 693-02
	CHECKED: S.L.D.		

bs_sdgn069302\069302pier.dgn 10/11/2005 9:23:31 AM