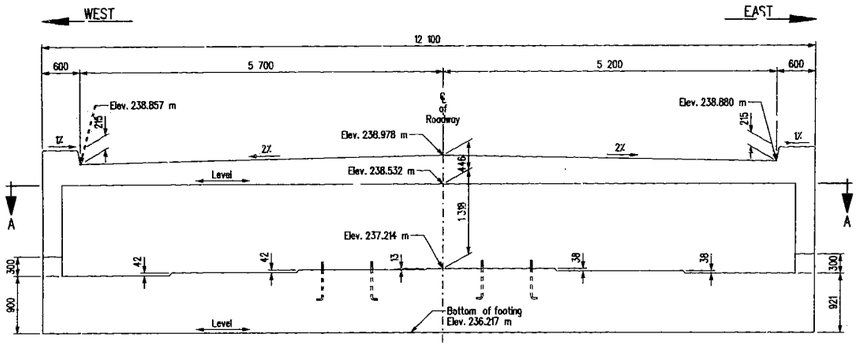

ELEVATION

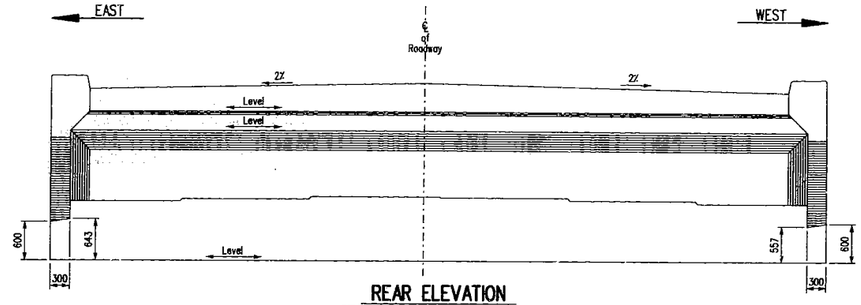

REAR ELEVATION

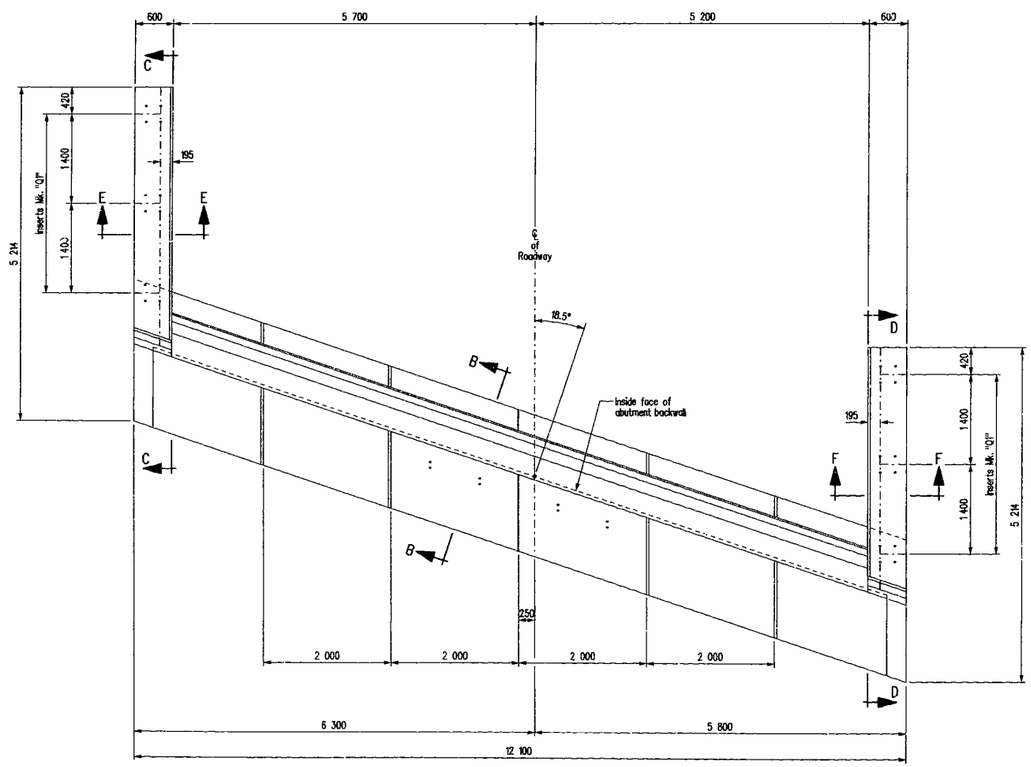

PLAN

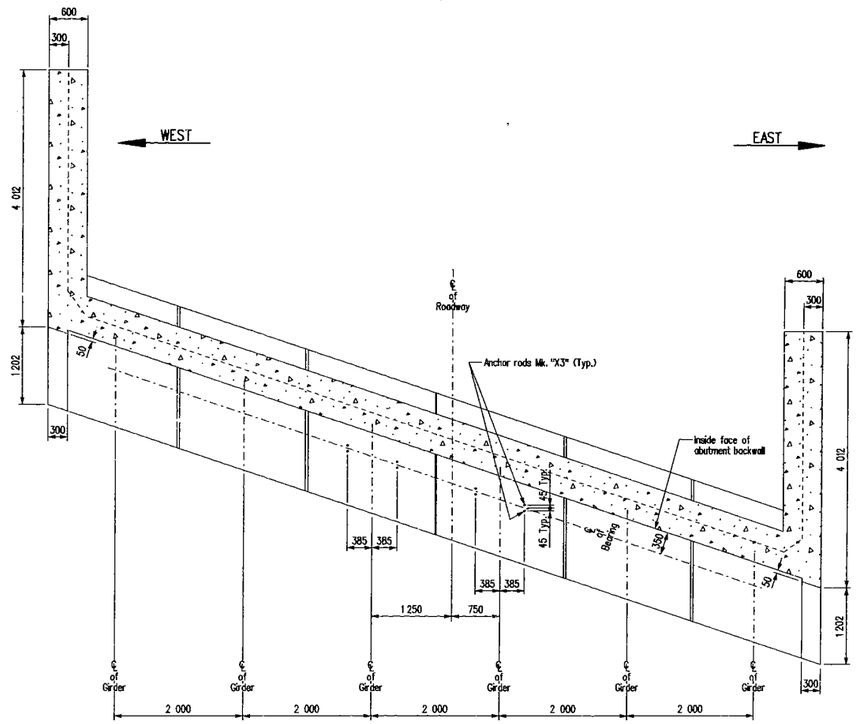

SECTION A-A

NOTE:

For SECTIONS B-B, C-C, D-D, E-E & F-F see Sheet No. 11.

REVISIONS		
OCT 31/07	R.A	AS BUILT
DATE	BY	DESCRIPTION

PROVINCE OF MANITOBA — A.H. PANKRATZ — Oct 12, 2005 — REGISTERED PROFESSIONAL ENGINEER

ABUTMENT CONCRETE DETAILS FOR SU.4

FOR PROPOSED 69 714 LONG R.C. BRIDGE
OVER SEINE RIVER DIVERSION
ON P.T.H. No. 59 SOUTH BOUND LANES, 10 900 ROADWAY
IN SEC. 28-8-4E

R.M. OF RITCHOT

Manitoba Transportation and Government Services
Bridges and Structures Branch

RELEASED FOR CONSTRUCTION
BY: _____ Oct-13/05
DIRECTOR OF BRIDGES AND STRUCTURES — DATE

DESIGN	BY: A.H.P.	
	CHECKED: J.P.L.	
DETAILS	BY: D.P.W.	
	CHECKED: A.H.P.	

SCALE: 1:40
SHEET No. 10
SITE No. 693-02

06B302\06B302abutment.dgn 10/11/2005 9:02:55 AM