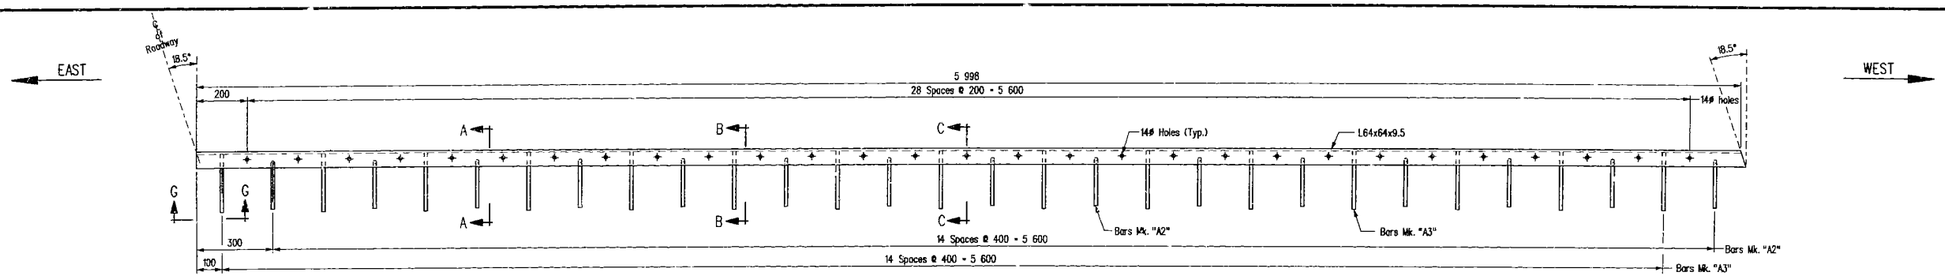

EDGE ANGLE Mk. "E5"

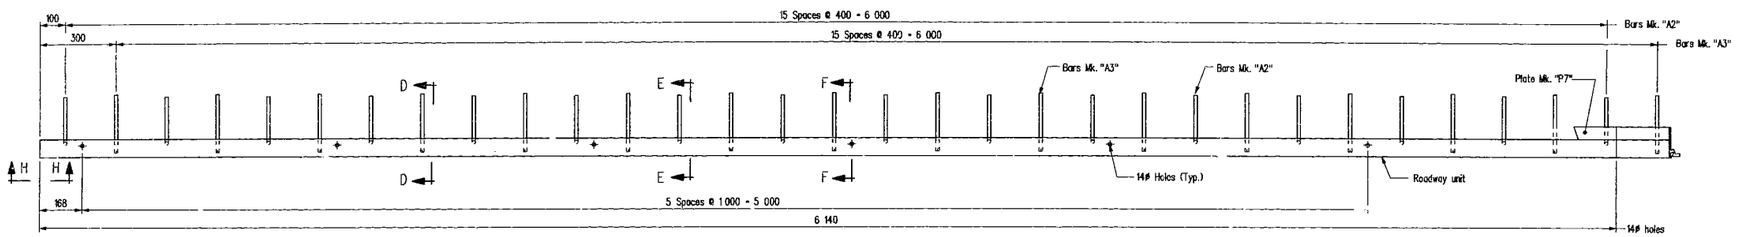

EXPANSION UNIT Mk. "E6"

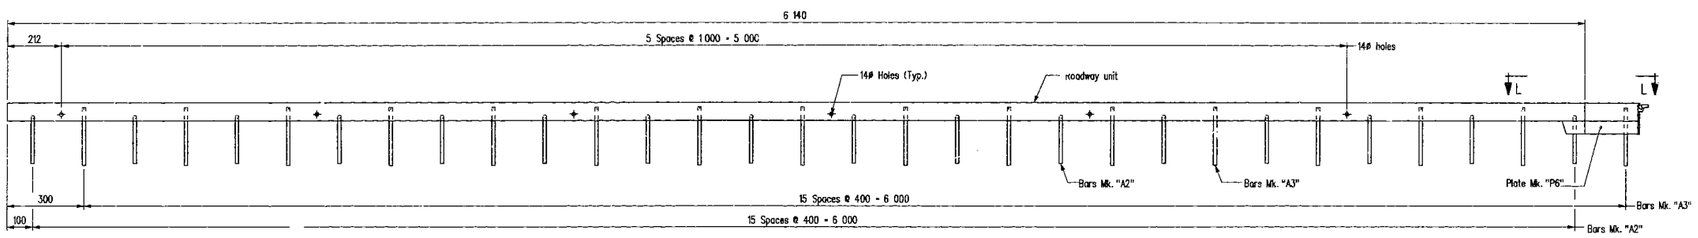

EXPANSION UNIT Mk. "E7"

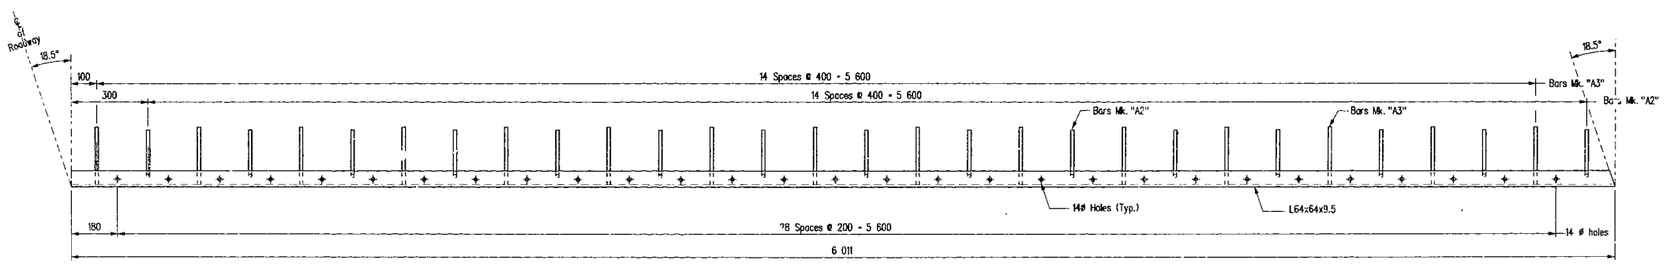

EDGE ANGLE Mk. "E8"

NOTE :

For Sections see sheet No. 45.

REVISIONS		
OCT 31/07	R-A	AS BUILT
DATE	BY	DESCRIPTION

PROVINCE OF MANITOBA
A. H. PANKRATZ
Oct 12, 2005
REGISTERED PROFESSIONAL ENGINEER

EXPANSION JOINT DETAILS

FOR PROPOSED 69 714 LONG R.C. BRIDGE
OVER SEINE RIVER DIVERSION
ON P.T.H. No. 59 SOUTH BOUND LANES, 10 900 ROADWAY
IN SEC. 28-8-4E

R.M. OF RITCHOT

Manitoba Transportation and Government Services
Bridges and Structures Branch

DESIGN	BY:	A.H.P.
	CHECKED:	J.B.L.
DETAILS	BY:	G.S.
	CHECKED:	A.H.P.

RELEASED FOR CONSTRUCTION
BY:

Oct. 13/05
DIRECTOR OF BRIDGES AND STRUCTURES — DATE

SCALE: 1:10

SHEET No. 43

SITE No. 693-02

ds_sec 063102 069302g2.dgn 10:11:2005 9:03:24 AM