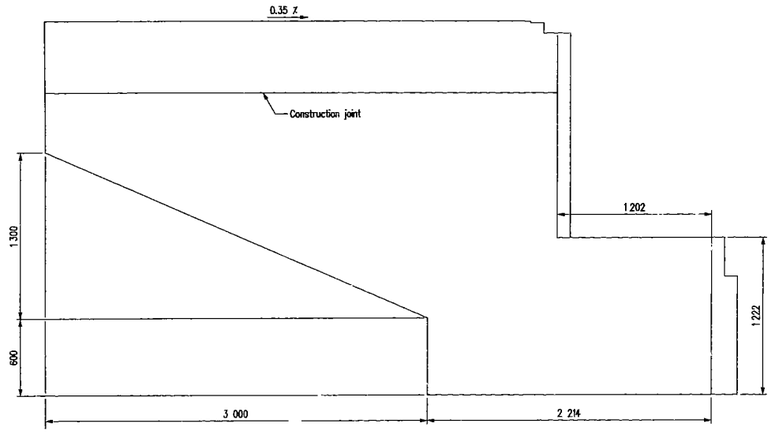

SIDE ELEVATION

Showing EAST wingwall for abutment SU.1

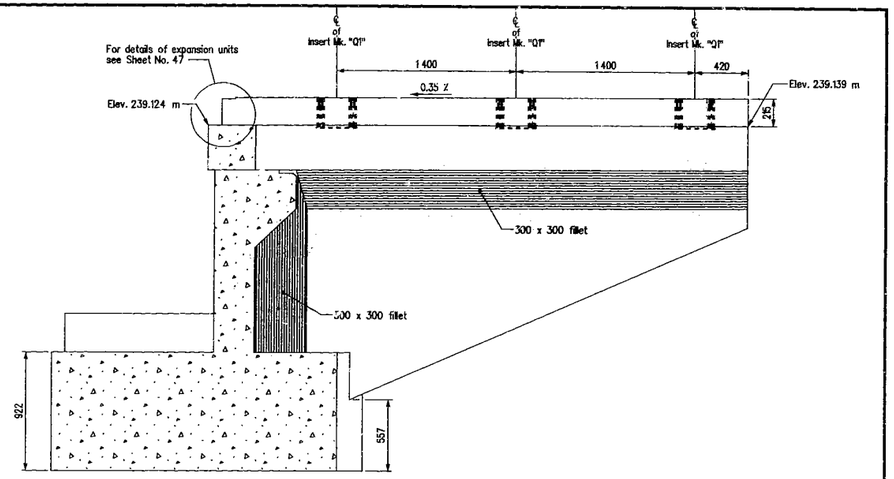

SECTION C-C

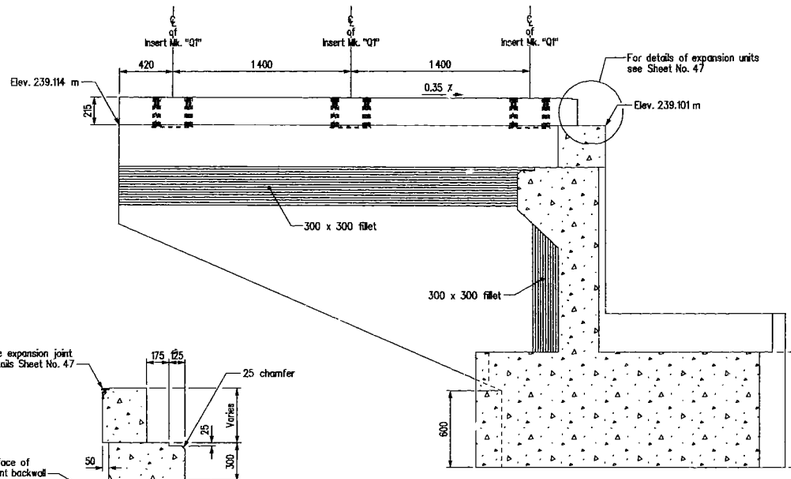

SECTION D-D

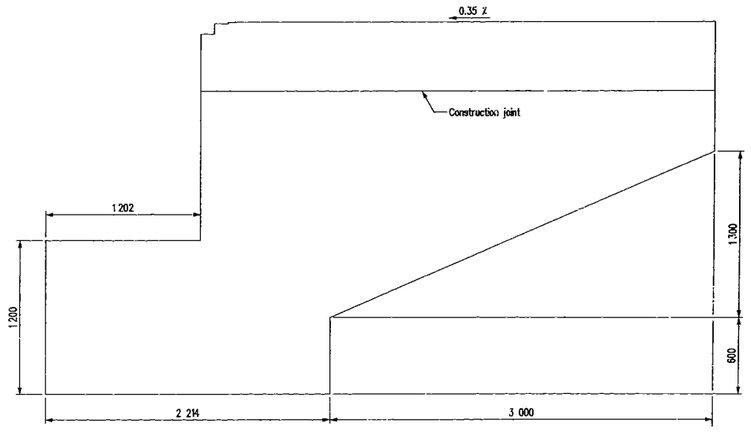

SIDE ELEVATION

Showing WEST wingwall for abutment SU.1

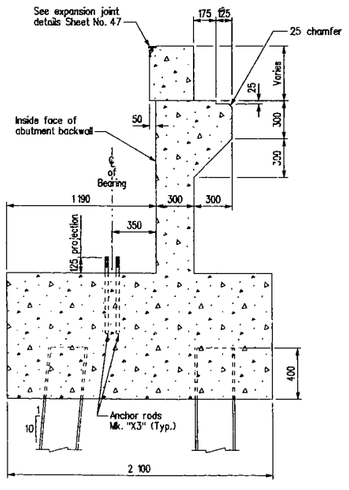

SECTION B-B

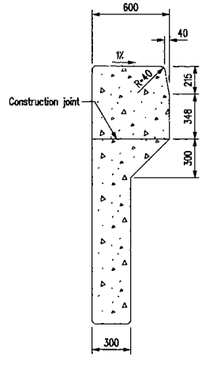

SECTION E-E

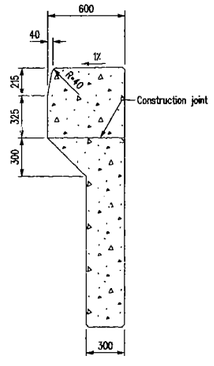

SECTION F-F

NOTES:

1. All exposed edges to be chamfered 20 mm unless noted otherwise.
2. For locations of SECTIONS B-B, C-C, D-D, E-E & F-F see Sheet No. 8.
3. For Bill of Inserts Mk. "Q1" see Sheet No. 51.
4. The concrete bearing seat shall be plane to within 1.0 mm across each bearing dimension.

PERMEABLE FORMWORK LINER FINISH: (For two abutments)

All outside face of wingwalls - 28.00 m²

All inside and end faces of curb - 11.00 m²

REVISIONS		
OCT 31/07	R.A	AS BUILT
DATE	BY	DESCRIPTION

PROVINCE OF MANITOBA — A. H. PANKRATZ — OCT 12, 1995 — REGISTERED PROFESSIONAL ENGINEER

ABUTMENT CONCRETE DETAILS FOR SU.1

FOR PROPOSED 69 714 LONG R.C. BRIDGE
OVER SEINE RIVER DIVERSION
ON P.T.H. No. 59 SOUTH BOUND LANES, 10 900 ROADWAY
IN SEC. 28-8-4E

R.M. OF RITCHOT

Manitoba Transportation and Government Services
Bridges and Structures Branch

RELEASED FOR CONSTRUCTION
BY:
Oct. 13 1995
DIRECTOR OF BRIDGES AND STRUCTURES — DATE

DESIGN	BY: A.H.P.	
	CHECKED: J.B.I.	
DETAILS	BY: D.P.W.	
	CHECKED: A.H.P.	

SCALE: 1:20

SHEET No. 9

SITE No. 693-02