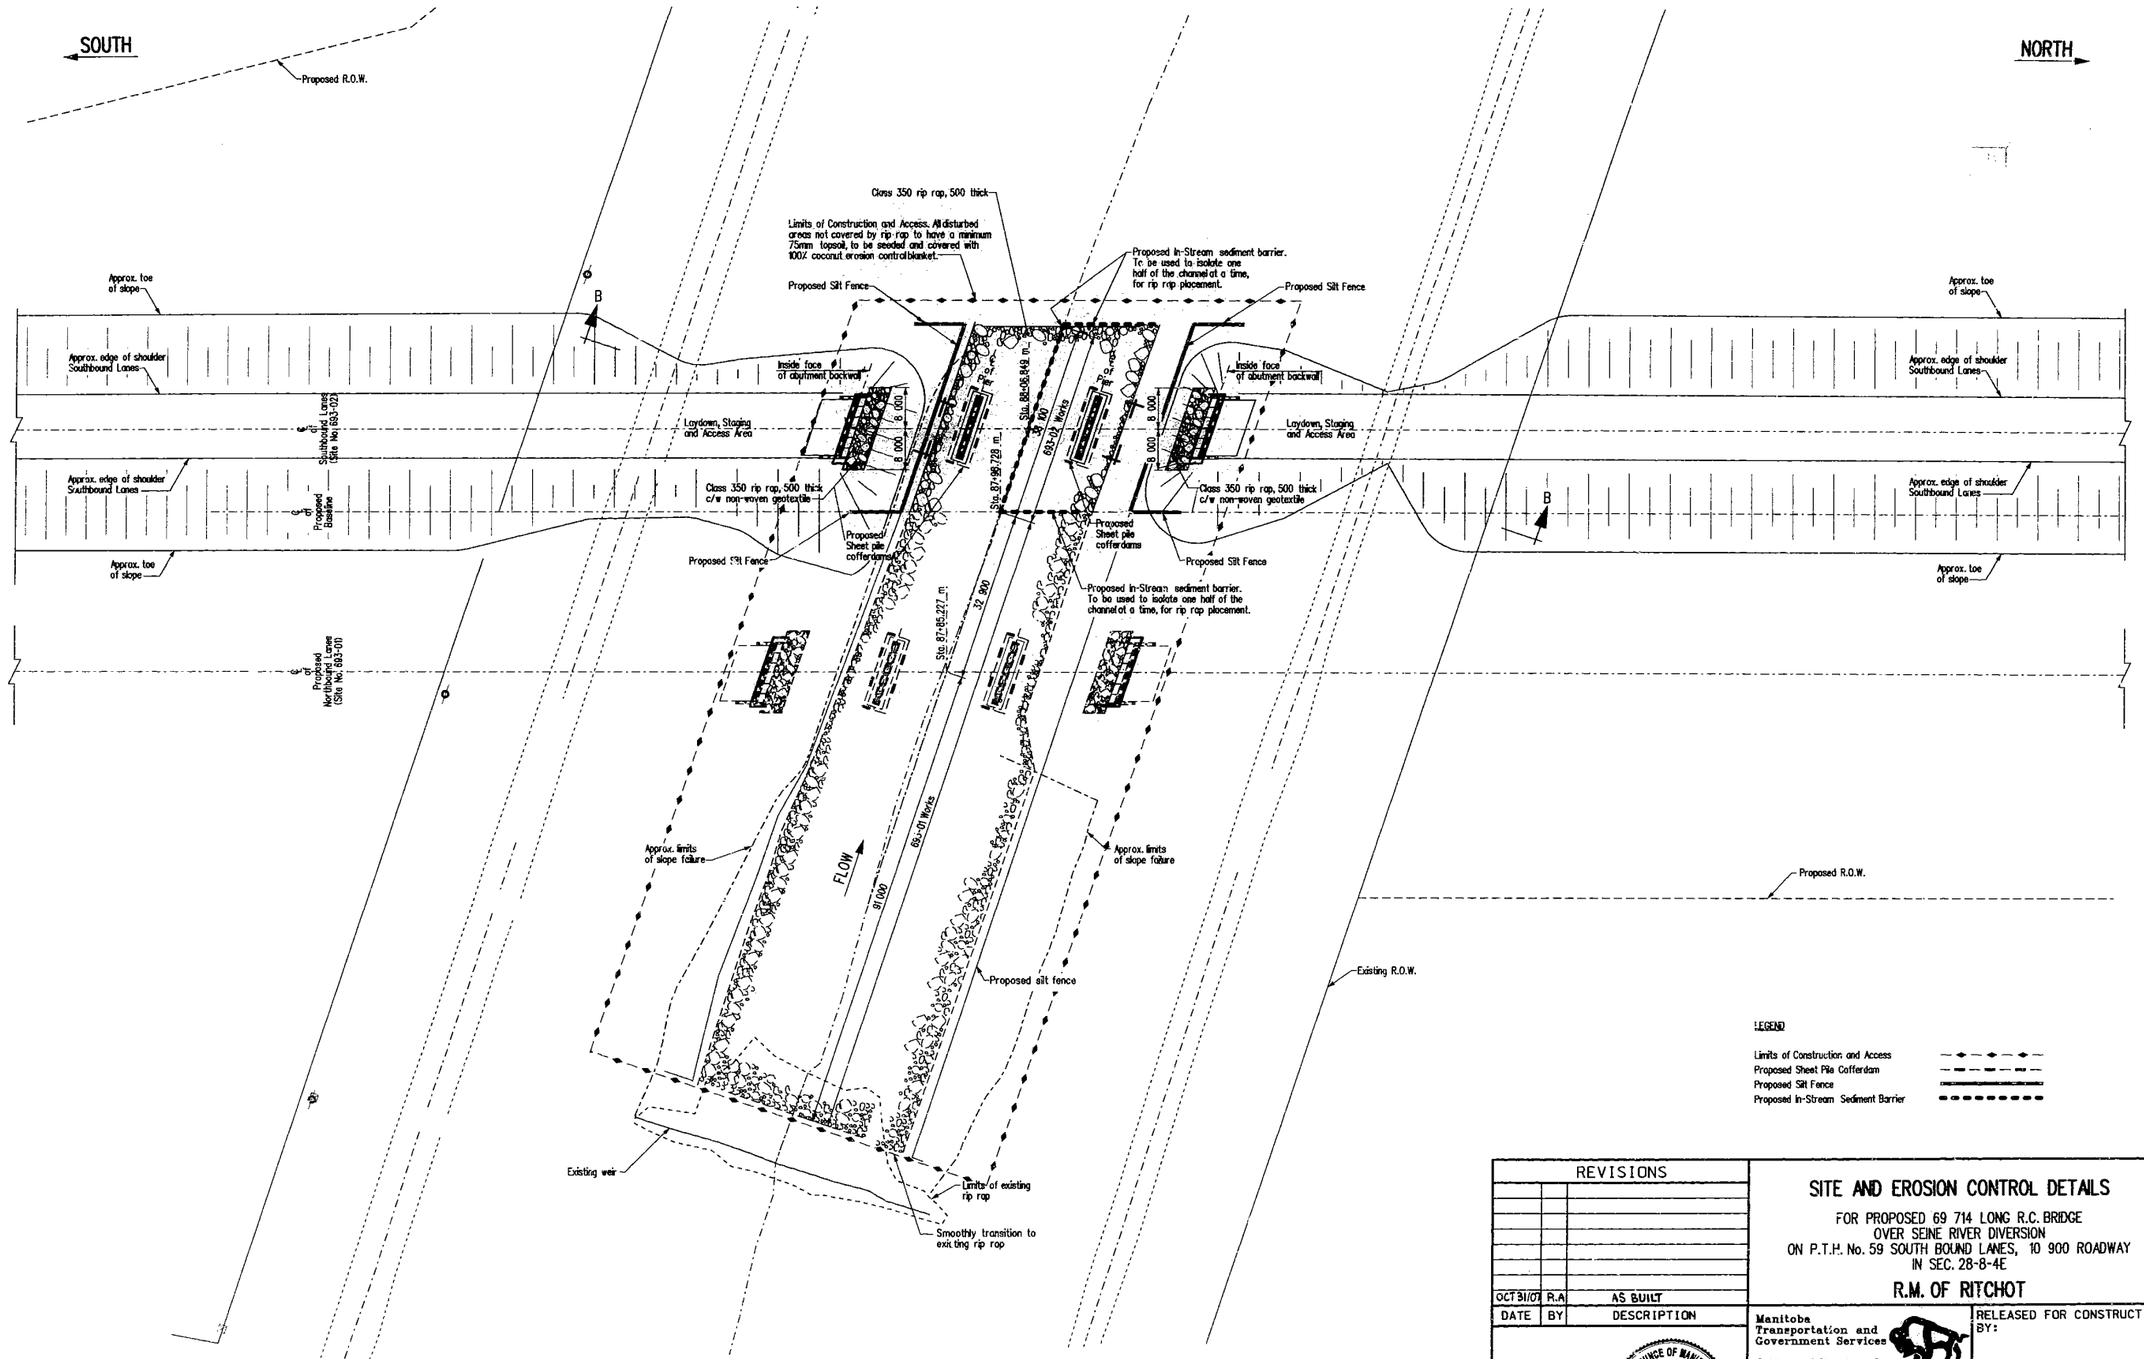

PLAN

Proposed bridge superstructures not shown for clarity

LEGEND

- Limits of Construction and Access
- Proposed Sheet Pile Cofferdam
- Proposed Silt Fence
- Proposed In-Stream Sediment Barrier

REVISIONS		
OCT 31/07	R.A	AS BUILT
DATE	BY	DESCRIPTION

PROVINCE OF MANITOBA — T. A. LOCK — OCT 12/05 — REGISTERED PROFESSIONAL ENGINEER

SITE AND EROSION CONTROL DETAILS

FOR PROPOSED 69 714 LONG R.C. BRIDGE
OVER SEINE RIVER DIVERSION
ON P.T.H. No. 59 SOUTH BOUND LANES, 10 900 ROADWAY
IN SEC. 28-8-4E

R.M. OF RITCHOT

Manitoba Transportation and Government Services
Bridges and Structures Branch

RELEASED FOR CONSTRUCTION BY:

DIRECTOR OF BRIDGES AND STRUCTURES — DATE: Oct. 31/05

DESIGN	BY: A.P./S.D./T.I.	
	CHECKED:	
DETAILS	BY: K.P./G.J./D.W./M.S./T.G.	
	CHECKED:	

SCALE: 1:500 or as shown — SHEET No. 3 — SITE No. 693-02

..\693\02\693302general.dgn 10/12/2005 1:30:40 PM